IREDELL COUNTY HEALTH DEPARTMENT

STATESVILLE 704-878-5305 MOORESVILLE 704-664-5281

IMPROVEMENT PERMIT / CERTIFICATE OF COMPLETION / OPERATION PERMIT / EXISTING SYSTEM INSPECTION

PROPERTY DESCRIPTION NO. 21713 DATE Aug 1, 95 TAX MAP NO. 2F12A67 / 4625-59-1997 Watershed: ☑ Yes ☐ No

OWNER OR CONTRACTOR Saussy Burbank PHONE: Business 896-0568 Home

ADDRESS PO Box 1764 Davidson

LOCATION Brawley Sch Rd TR Bay Harbour, TL Beach Front at end

SUBDIVISION The Harbour BLOCK / SECTION 1 LOT 67 LOT AREA 50,423 ft² SITE CLASS. B per 1996 DESIGN FLOW 480 gpd L.T.A.R. .13

Septic Tank: 1000 Gallons; STB 794 Date 11-3-95

Pump Tank: Gallons; PT Date

Pump Make: Model Serial No.

Nitrification Field: No Fields 1 Square Feet 1200 Linear Feet 400

No Lines 4-5 Trench Width 36" Max Trench Bottom Depth 36" Gravel Depth NA

☑ New System ☐ Repair System Type: I, II, III, IV, V, VI

System Description: gravity Infiltrator

Repair System Description: gravity PPBDS

Maintenance Agreement Required: ☐ Yes ☐ No

☑ House/Mod. Home No. Bedrooms 4

☐ Mobile Home No. Bathrooms 2.5

☐ Business No. Employees

☐ Other


☐ Slab ☑ Crawl Space ☐ Basement w/plumbing ☐ Basement wo/plumbing

Water Supply: ☐ Individual ☑ Community ☐ Public


Comments: Exit plumbing at grade where shown.

Comments: 1/23/96 - Only S/T set today

INITIAL SITE SKETCH

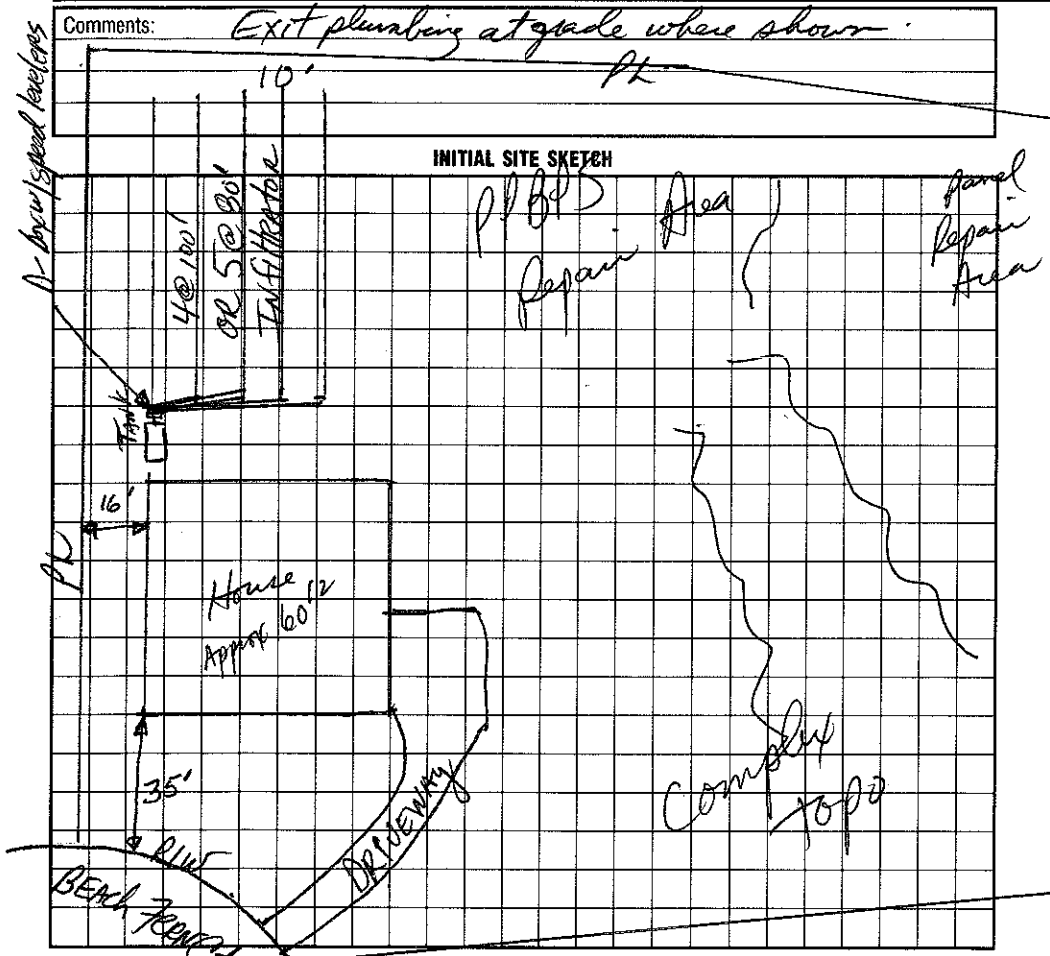

AS BUILT SKETCH

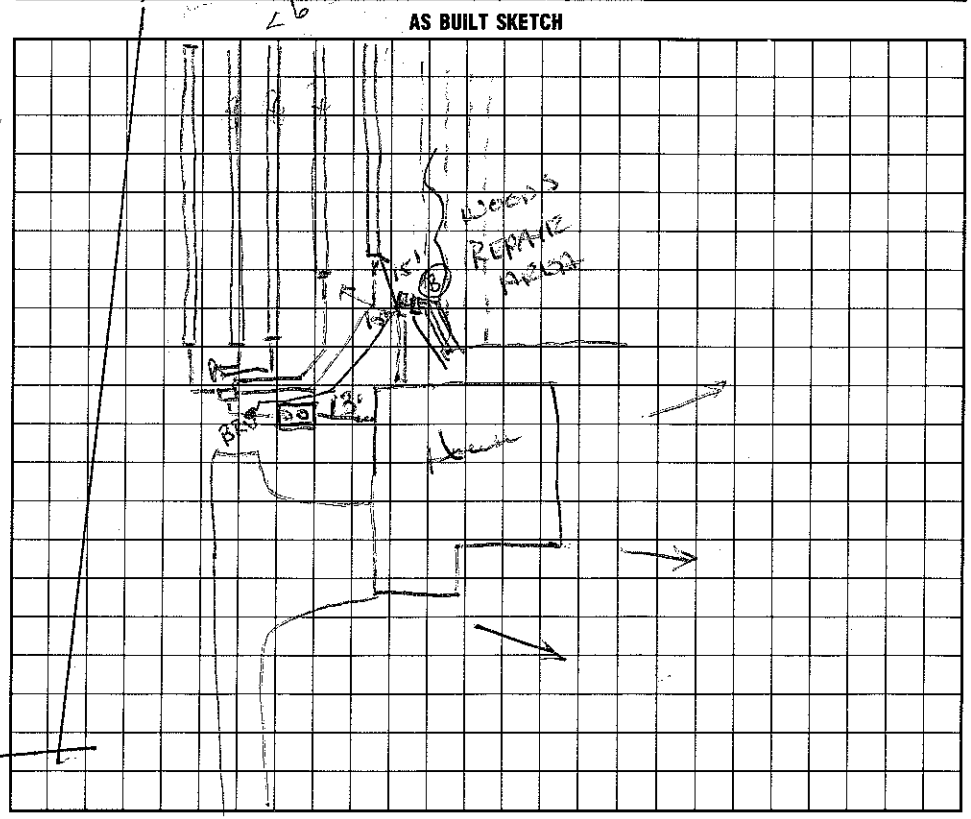

I understand that this permit can be suspended or revoked if any false information is supplied toward securing the permit/any unauthorized changes are made to the site/any unauthorized changes are made in the installation of the system.

Signed: [signature]

Improvement Permit by: Jackie Hyman, RS date 8-1-95

Existing System Inspection by: date

Installed by: Barry Thompson

Certificate of Completion by: Wesley Sparks RS date 1/26/96

Operation Permit by: Wesley Sparks RS date 1/26/96

HEALTH DEPT. COPY: WHITE INSPECTION COPY (FINAL): GREEN OWNER COPY (FINAL): YELLOW INSPECTION COPY (INITIAL): PINK OWNER COPY (INITIAL): GOLD