IREDELL COUNTY HEALTH DEPARTMENT

STATESVILLE 704-878-5305 MOORESVILLE 704-664-5281

IMPROVEMENT PERMIT / CERTIFICATE OF COMPLETION / OPERATION PERMIT / EXISTING SYSTEM INSPECT

PROPERTY DESCRIPTION NO. 20148 DATE March 4 95 TAX MAP NO. part of 2CA3 4625592397 Watershed: ☑ Yes ☐ No WS IV

OWNER OR CONTRACTOR Crescent Resources, Inc / MI Homes PHONE: Business Home

ADDRESS PO Box 1003 Charlotte

LOCATION Brawley Sch Rd. TR Bay Harbour Rd. TL Lake Mist TR Sunrise Circle on left

SUBDIVISION The Harbour BLOCK / SECTION 1 MAP D LOT 26 LOT AREA 28,733 ft² SITE CLASS. PS on 1957C DESIGN FLOW 480 gpd L.T.A.R. .3

Septic Tank: 1000 Gallons; STB 794 Date 6/6/95

Pump Tank: 1000 Gallons; PT 27 Date 7/2/95

Pump Make: Model Serial No.

Nitrification Field: No Fields 1 Square Feet 1600 Linear Feet 534

No Lines 6 Trench Width 36" Max Trench Bottom Depth 30" Gravel Depth 12"

☑ New System ☐ Repair System Type: I, II, (III) IV, V, VI

System Description: pump / Conventional field

Repair System Description: PBR Soil Infiltrator

Maintenance Agreement Required: ☐ Yes ☑ No

☑ House/Mod. Home No. Bedrooms 4

☐ Mobile Home No. Bathrooms 3

☐ Business No. Employees

☐ Other

☐ Slab ☑ Crawl Space ☐ Basement w/plumbing ☐ Basement wo/plumbing


Water Supply: ☐ Individual ☑ Community ☐ Public

Comments: Pressure manifold to be used if 6 hole H-box not Available (4" sch 80 pvc w/ 6 (½" taps) 6" o.c.

Comments: DEVELOPER PERMIT READY TO ISSUE 4/3/95

1" = 50'

INITIAL SITE SKETCH

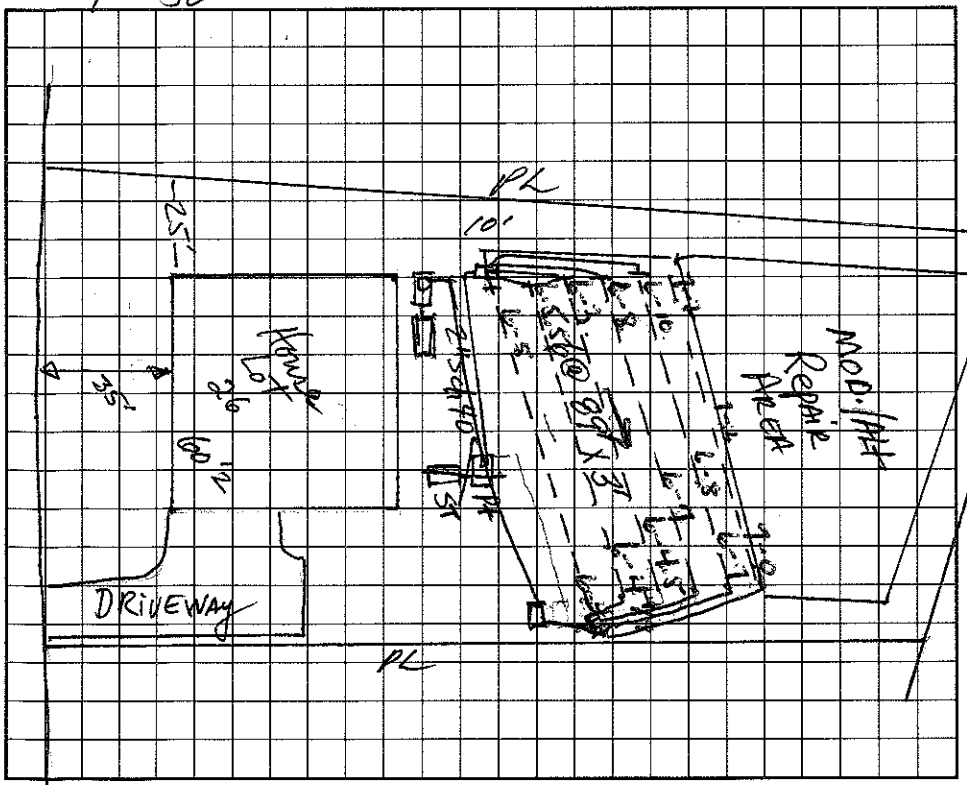

AS BUILT SKETCH

I understand that this permit can be suspended or revoked if any false information is supplied toward securing the permit/any unauthorized changes are made to the site/any unauthorized changes are made in the installation of the system. Improvement Permit is valid for 60 months from date of issuance.

Signed: X Agent

Improvement Permit by: date 3/4/95

Existing System Inspection by: date

Installed by: R L Maitland

Certificate of Completion by: Walter Lightfoot Construct Wesley Sparkes R.S. date 10/25/95

Operation Permit by: Wesley Sparkes R.S. date 10/25/95

HEALTH DEPT. COPY: WHITE INSPECTION COPY (FINAL): GREEN OWNER COPY (FINAL): YELLOW INSPECTION COPY (INITIAL): PINK OWNER COPY (INITIAL): GOLD