IREDELL COUNTY HEALTH DEPARTMENT

STATESVILLE 704-878-5305 MOORESVILLE 704-664-5281

IMPROVEMENT PERMIT / CERTIFICATE OF COMPLETION / OPERATION PERMIT / EXISTING SYSTEM INSPECTION

PROPERTY DESCRIPTION NO. 18994 DATE April 6, '95 TAX MAP NO. part of 2CA3 / 4625-59-3009 Watershed: ☑ Yes ☐ No

OWNER OR CONTRACTOR Crescent Resources Dev. MI Homes PHONE: Business Home WSD

ADDRESS PO Box 1003 Charlotte

LOCATION 1100 TR Bay Harbour Dr TL Lake Mist revised TR Sunrise Circle

SUBDIVISION The Harbours BLOCK / SECTION 1 LOT 29 LOT AREA 24,000 ft²+ SITE CLASS PSpec 1956 DESIGN FLOW 360 gpd L.T.A.R. .3

Septic Tank: 1000 Gallons; STB 794 Date 3/19/96

Pump Tank: Gallons; PT Date

Pump Make: Model Serial No.

Nitrification Field: No Fields 1 Square Feet Linear Feet 200+

No Lines 3 Trench Width 24" Max Trench Bottom Depth 36" Gravel Depth NA

☑ New System ☐ Repair System Type: I, II, III, IV, V, VI

System Description: gravity PPBPS

Repair System Description: Same as prior INF

Maintenance Agreement Required: ☐ Yes ☑ No

☑ House/Mod. Home No. Bedrooms 3

☐ Mobile Home No. Bathrooms 3

☐ Business No. Employees

☐ Other

☐ Slab ☑ Crawl Space ☐ Basement w/plumbing ☐ Basement wo/plumbing


Water Supply: ☐ Individual ☑ Community ☐ Public

Comments: laterals to follow contour 33 Pin EE

Comments: DEVELOPER PERMIT Ready to issue 2-20-96 DPH

1" = 50'

INITIAL SITE SKETCH

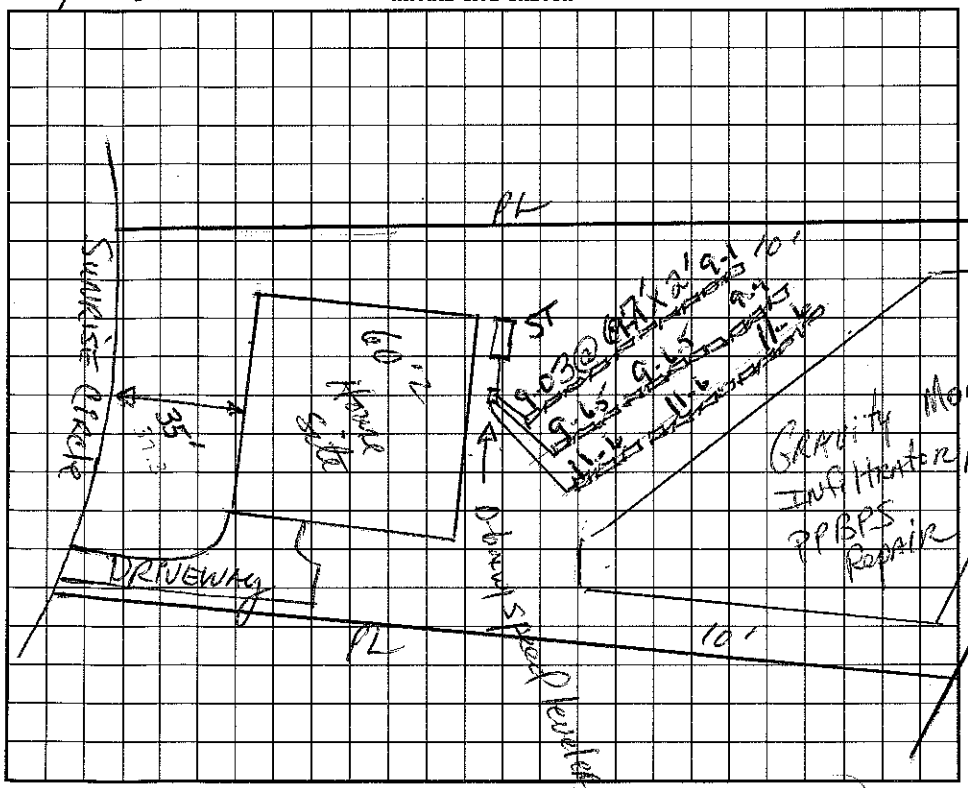

AS BUILT SKETCH

I understand that this permit can be suspended or revoked if any false information is supplied toward securing the permit/any unauthorized changes are made to the site/any unauthorized changes are made in the installation of the system. Improvement Permit is valid for 60 months from date of issuance.

Signed: [signature]

Improvement Permit by: [signature], RS date 4/6/95

Existing System Inspection by: [signature], RS date 2/20/96

Authorization to construct

Installed by: R. Macleod Const

Certificate of Completion by: date

Operation Permit by: Wesley Sparks RS date 10/29/96

HEALTH DEPT. COPY: WHITE INSPECTION COPY (FINAL): GREEN OWNER COPY (FINAL): YELLOW INSPECTION COPY (INITIAL): PINK OWNER COPY (INITIAL): GOLD