IREDELL COUNTY HEALTH DEPARTMENT

Authorization to Construct

STATESVILLE 704-878-5305 MOORESVILLE 704-664-5281

IMPROVEMENT PERMIT / ~~CERTIFICATE OF COMPLETION~~ / OPERATION PERMIT / EXISTING SYSTEM INSPECTION

PROPERTY DESCRIPTION NO. 22829 DATE 1/10/96 TAX MAP NO. 2F 12 A 28 Watershed: ☒ Yes ☐ No

OWNER OR CONTRACTOR MI Homes PHONE: Business 376-9800 ~~Home~~ 4625-59-3139

ADDRESS 1043 E. Morehead St. #105 Charlotte, NC. 28204

LOCATION Brawley Sch TR Bay Harbour TL Lake Mist Dr. TR Sunrise Cir TL to 2nd lot on L

SUBDIVISION Harbour BLOCK / SECTION 1 LOT 28 LOT AREA 21000 SITE CLASS. PS DESIGN FLOW 360 L.T.A.R. .3

Septic Tank: 1000 Gallons; STB 794 Date 6/11/96

Pump Tank: _____ Gallons; PT _____ Date _____

Pump Make: _____ Model _____ Serial No. _____

Nitrification Field: No Fields 1 Square Feet 1200 Linear Feet *300

No Lines 4 Trench Width 36" Max Trench Bottom Depth 36"

☒ New System ☐ Repair System Type: I, II, ☒ III, IV, V, VI

System Description: GRAVITY - INFILTRATOR

Repair System Description: SAME

Maintenance Agreement Required: ☒ Yes ☐ No 5/412

Gravel Depth 6" SAND ☐ Slab ☒ Crawl Space ☐ Basement w/plumbing ☐ Basement wo/plumbing

☒ House/Mod. Home No. Bedrooms 3

☐ Mobile Home No. Bathrooms 3.5

☐ Business No. Employees _____


☐ Other _____

Water Supply:
☐ Individual
☒ Community
☐ Public


Comments: * 25% reduction for single trench use
Sand backfill required to top of louvers on each panel.

Comments:

INITIAL SITE SKETCH

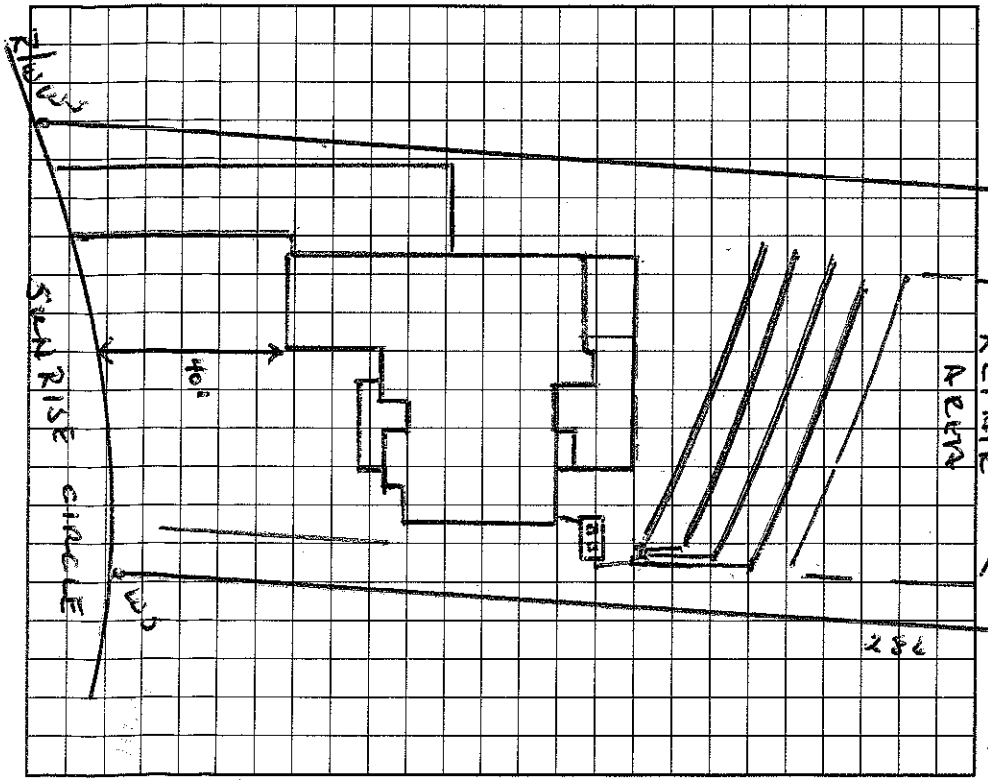

AS BUILT SKETCH

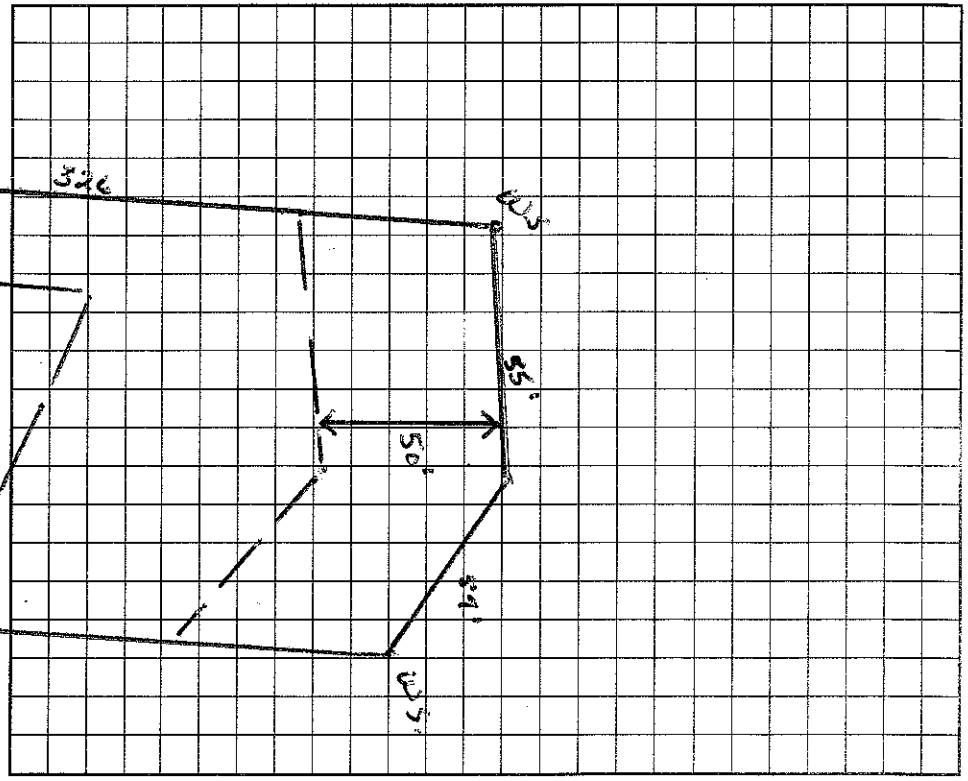

I understand that this permit can be suspended or revoked if any false information is supplied toward securing the permit/any unauthorized changes are made to the site/any unauthorized changes are made in the installation of the system.

Signed: Marvin D. Omar

Improvement Permit by: Wesley Sparks RS. date 1/10/96

Authorization to Construct Existing system inspection by: Wesley Sparks RS. date 1/10/96

Installed by: RL MacLeod Const.

Certificate of Completion by: _____ date _____

Operation Permit by: Wesley Sparks RS. date 8/9/96

HEALTH DEPT. COPY: WHITE INSPECTION COPY (FINAL): GREEN OWNER COPY (FINAL): YELLOW INSPECTION COPY (INITIAL): PINK OWNER COPY (INITIAL): GOLD