Ph 1 Lot 50 4625 59 5649

# IREDELL COUNTY HEALTH DEPARTMENT

STATESVILLE 704-878-5305 MOORESVILLE 704-664-5281

## IMPROVEMENT PERMIT / CERTIFICATE OF COMPLETION / OPERATION PERMIT / EXISTING SYSTEM INSPECTION

PROPERTY DESCRIPTION NO. REPAIR 19010 DATE 9/3/97 TAX MAP NO. REPAIR 2CA3 pt of Watershed: ☑ Yes ☐ No

OWNER OR CONTRACTOR MI HOMES PHONE: Business 663 6905 Home

ADDRESS

LOCATION BAYHARBOUR - TL LAKE MIST - TR SUNRISE CIRCLE - 2ND ON RT

SUBDIVISION HARBOUR BLOCK / SECTION 1 LOT 50,504 LOT AREA 7 20,000 FT SITE CLASS. PS DESIGN FLOW 480 L.T.A.R. .4

Septic Tank: EXISTING Gallons; STB Date

Pump Tank: Gallons; PT Date

Pump Make: Model Serial No.

Nitrification Field: No Fields 1 Square Feet 1200 Linear Feet 400

No Lines ~~4 @ 100'~~ 5 Trench Width 36" Max Trench Bottom Depth AS NEEDED Gravel Depth N/A

☐ New System ☑ Repair System Type: I, II, ⓘ, IV, V, VI

System Description:

Repair System Description: PUMP CHAMBERED OR HDS

Maintenance Agreement Required: ☐ Yes ☑ No

☑ House/Mod. Home No. Bedrooms 4

☐ Mobile Home No. Bathrooms 4

☐ Business No. Employees

☐ Other


☐ Slab ☑ Crawl Space ☐ Basement w/plumbing ☐ Basement wo/plumbing

Water Supply: ☐ Individual ☑ Community ☐ Public


Comments: LINES WILL BE GOING AGAINST THE GRADE - START OUT SHALLOW AS POSSIBLE - 24" ≈ 1 FOOT ELEVATION DIFFERENCE.

Comments:

**INITIAL SITE SKETCH**

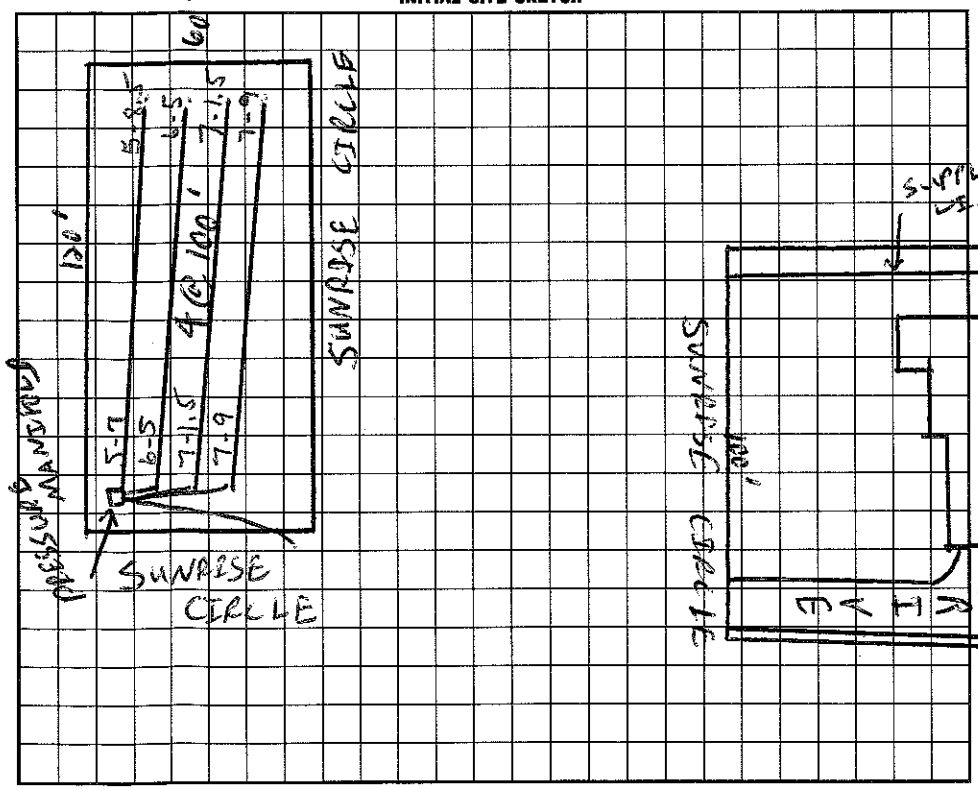


**AS BUILT SKETCH**

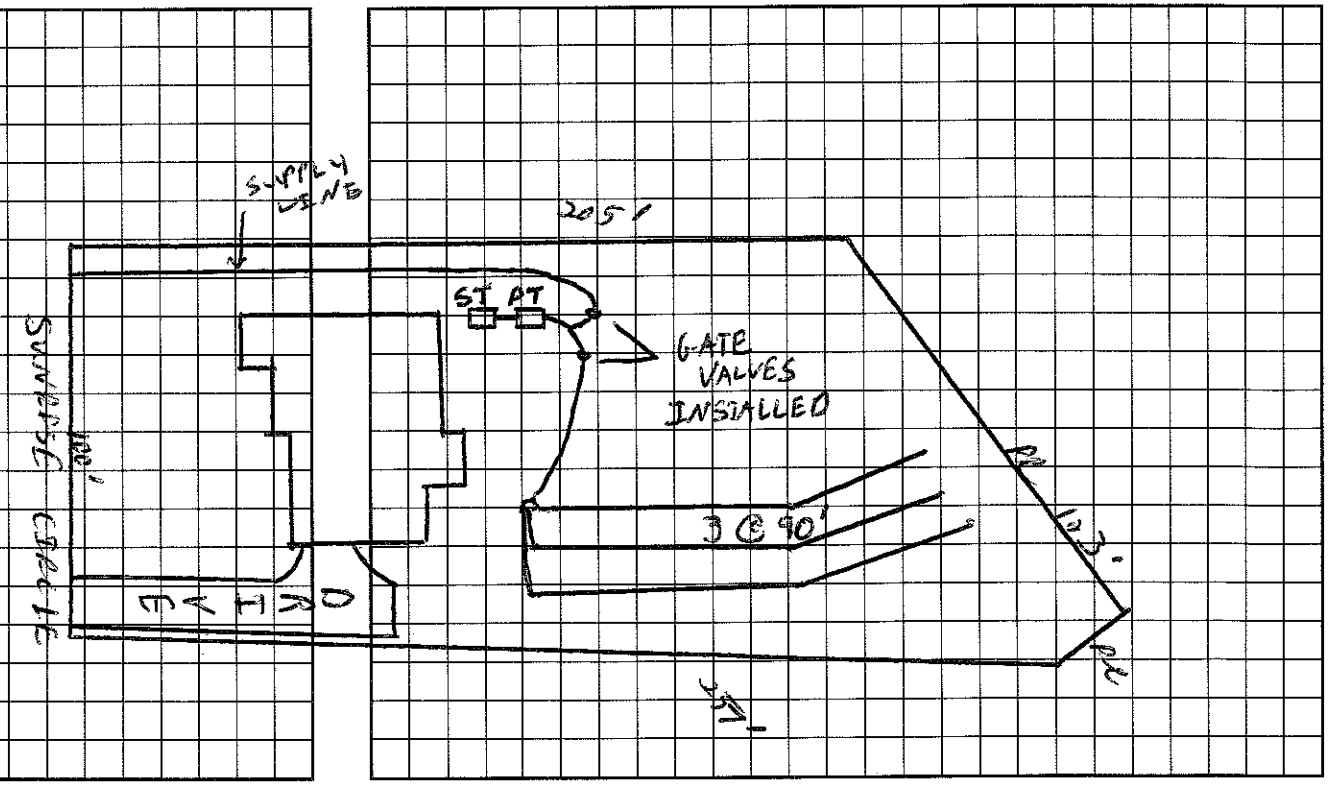


I understand that this permit can be suspended or revoked if any false information is supplied toward securing the permit/any unauthorized changes are made to the site/any unauthorized changes are made in the installation of the system. Improvement Permit is valid for 60 months from date of issuance.

Signed:

Improvement Permit by: date 9/3/97

Existing System Inspection by: date 9/3/97

Installed by: Macleod Const

Certificate of Completion by: Wesley Sparks RS date 9/16/97

Operation Permit by: Wesley Sparks RS date 9/16/97

HEALTH DEPT. COPY: WHITE INSPECTION COPY (FINAL): GREEN OWNER COPY (FINAL): YELLOW INSPECTION COPY (INITIAL): PINK OWNER COPY (INITIAL): GOLD