IREDELL COUNTY HEALTH DEPARTMENT

STATESVILLE 704-878-5305 MOORESVILLE 704-664-5281

IMPROVEMENT PERMIT / CERTIFICATE OF COMPLETION / OPERATION PERMIT / EXISTING SYSTEM INSPECTION

PROPERTY DESCRIPTION NO. 19010 DATE Oct 24 '95 TAX MAP NO. part of Watershed: ☑ Yes ☐ No

OWNER OR CONTRACTOR MI Homes PHONE: Business Home WS4

ADDRESS

LOCATION Bay Harbour Rd TL LAKE NIST TR Sunrise Circle 2nd on right

SUBDIVISION The Harbour BLOCK / SECTION LOT 30, 30A LOT AREA 720,000 ft² SITE CLASS. A pre 1956 DESIGN FLOW 360 gpd L.T.A.R. .25

Septic Tank: 1000 Gallons; STB T94 Date 6/7/96

Pump Tank: 1000 Gallons; PT 27 Date 5/31/96

Pump Make: Liberty Model LE 71 A2 Serial No. MDE 29340

Nitrification Field: No Fields 1 Square Feet Linear Feet 240

No Lines 3 @ 80' + Trench Width 24" Max Trench Bottom Depth 30" Gravel Depth NA

☑ New System ☐ Repair System Type: I, II, III, IV, V, VI

System Description: LPPBRS

Repair System Description: Off site LPPBRS

Maintenance Agreement Required: ☑ Yes ☐ No

☑ House/Mod. Home No. Bedrooms 3

☐ Mobile Home No. Bathrooms 3

☐ Business No. Employees

☐ Other


☐ Slab ☑ Crawl Space ☐ Basement w/plumbing ☐ Basement wo/plumbing

Water Supply: ☐ Individual ☑ Community ☐ Public

Comments: Septic TANK INSTALLER NOTE: This drainfield must be kept NO deeper than 30" trench bottom and start 16' right side property line. Divert storm water towards

Comments: front and around house. Do not cut roots drainfield area. OK to clean out organic debris from eroded areas and fill w/ dirt.

INITIAL SITE SKETCH

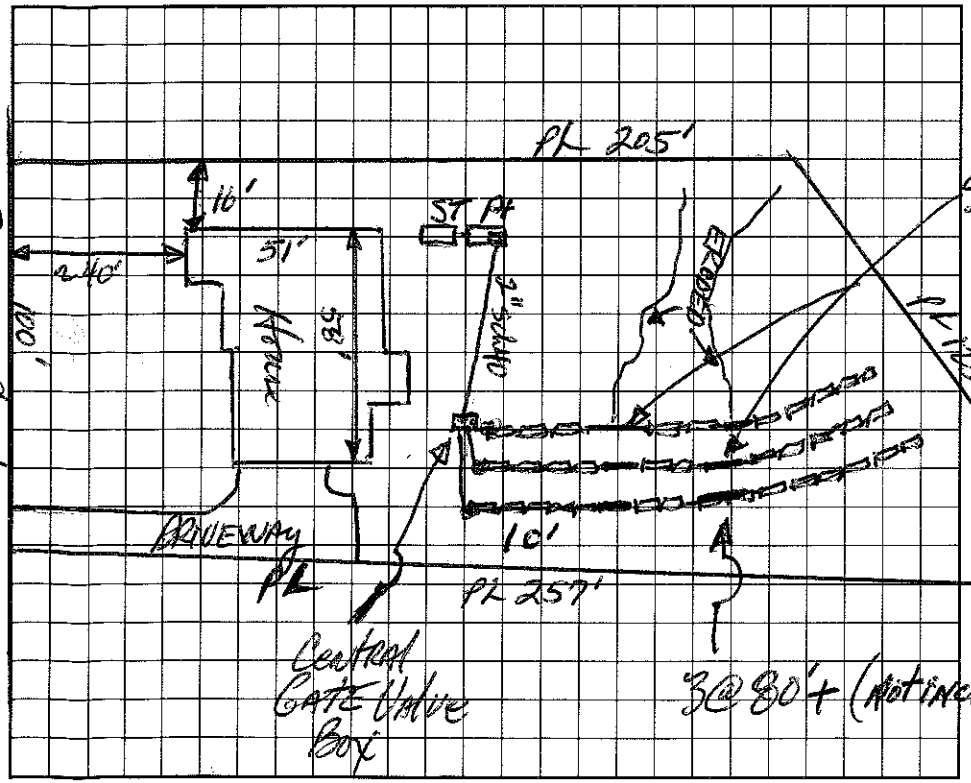

AS BUILT SKETCH

55 x 3.6 = 198

x .66 = 130

= 6.5 drawdown

8/21/96 - Seal conduit between PIT and electrical connections @ No clean found

8-2, 7, 8, 9 - Not finished each date

I understand that this permit can be suspended or revoked if any false information is supplied toward securing the permit/any unauthorized changes are made to the site/any unauthorized changes are made in the installation of the system.

Signed: ✗ MEAN Cole

Improvement Permit by: DC Hanson, RS date 10/25/95

Existing System Inspection by: DC Hanson, RS date 10/25/95

Auth to Construct

Installed by: MacLeod Const.

Certificate of Completion by: date

Operation Permit by: Wesley Sparks R.S. date 8/21/96

MEAN COPY: WHITE INSPECTION COPY (FINAL): GREEN OWNER COPY (FINAL): YELLOW INSPECTION COPY (INITIAL): PINK OWNER COPY (INITIAL): GOLD