# IREDELL COUNTY HEALTH DEPARTMENT

Auth[illegible]tion to Construct

[illegible]SVILLE 704-878-5305 MOORESVILLE 704-664-5281

## IMPROVEMENT PERMIT / CERTIFICATE OF COMPLETION / OPERATION PERMIT / EXISTING SYSTEM INSPECTION

PROPERTY DESCRIPTION NO. 25418 DATE 4/16/97 TAX MAP NO. 12F 12A 57 Watershed: ☒ Yes ☐ No

OWNER OR CONTRACTOR MI Homes PHONE: Business 376-9800 ~~Home~~ 4625-59-6116

ADDRESS 1043 MacLeod St. Suite 105 Charlotte NC

LOCATION [illegible] TR Bay Harbour Tr Lake Mist – 7th lot on (R) after Cypress Cove

SUBDIVISION HARBOUR BLOCK / SECTION II LOT 57 LOT AREA .83 AC SITE CLASS. PS DESIGN FLOW 480 L.T.A.R. .3

Septic Tank: 1000 Gallons; STB 794 Date 2/13/97

Pump Tank: ______ Gallons; PT ______ Date ______

Pump Make: ______ Model ______ Serial No. ______

Nitrification Field: No Fields 1 Square Feet 1200* Linear Feet 400*

No Lines 4 Trench Width 36" Max Trench Bottom Depth 36" Gravel Depth SAND

☒ New System ☐ Repair System Type: I, II, (III), IV, V, VI

System Description: GRAV – CH PLASTIC

Repair System Description: GRAV – PPBS 16"

Maintenance Agreement Required: ☐ Yes ☒ No

☒ House/Mod. Home ☐ Mobile Home ☐ Business ☐ Other

No. Bedrooms 4 No. Bathrooms 4 No. Employees ______

☐ Slab ☒ Crawl Space ☐ Basement w/plumbing ☐ Basement wo/plumbing


Water Supply: ☐ Individual ☒ Community ☐ Public

Comments: REDRAW
25% reduction for Ch Plastic

Comments:

INITIAL SITE SKETCH

AS BUILT SKETCH

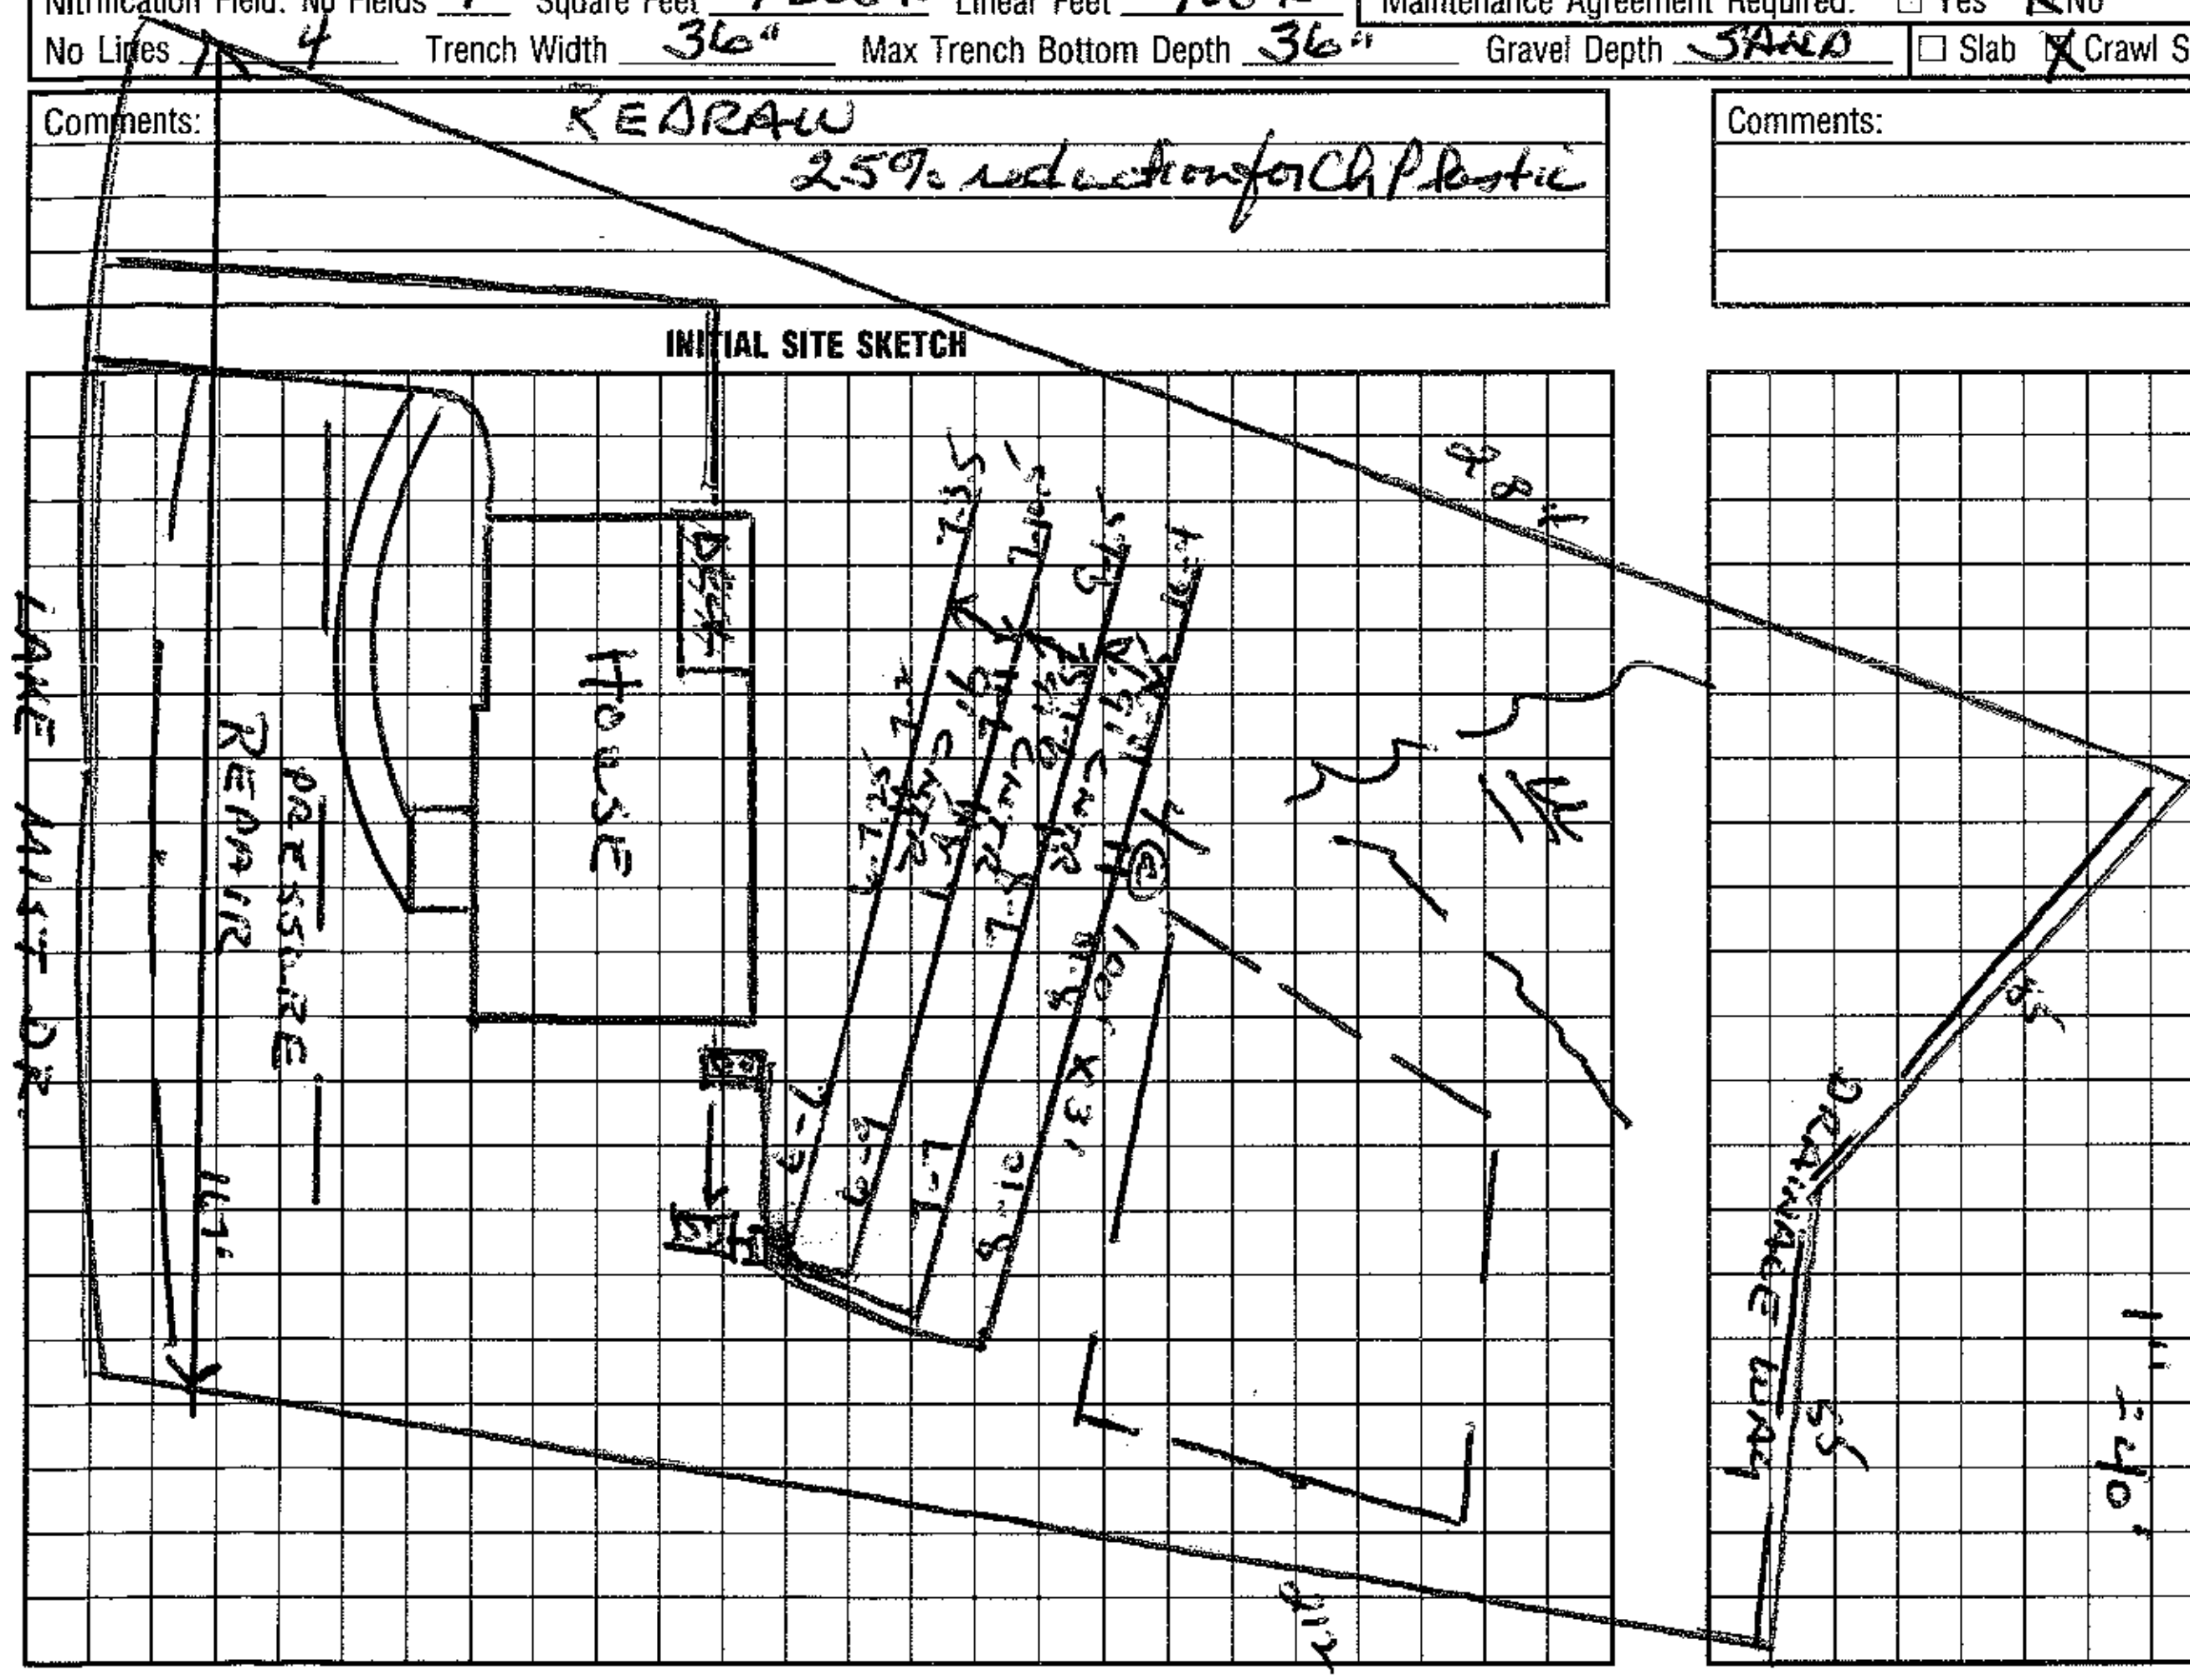


I understand that this permit can be suspended or revoked if any false information is supplied toward securing the permit/any unauthorized changes are made to the site/any unauthorized changes are made in the installation of the system. Improvement Permit is valid for 60 months from date of issuance.

Signed: * [signature]

Improvement Permit by: Wesley Sparks R.S. date 4/16/97

Auth to Const / Existing System Inspection by: Wesley Sparks R.S. date 4/16/97

Installed by: MacLeod Const Co.

Certificate of Completion by: Wesley Sparks R.S. date 4/17/97

Operation Permit by: Wesley Sparks R.S. date 4/17/97

HEALTH DEPT. COPY: WHITE INSPECTION COPY (FINAL): GREEN OWNER COPY (FINAL): YELLOW INSPECTION COPY (INITIAL): PINK OWNER COPY (INITIAL): GOLD