IREDELL COUNTY HEALTH DEPARTMENT

STATESVILLE 704-878-5305 MOORESVILLE 704-664-5281

IMPROVEMENT PERMIT / CERTIFICATE OF COMPLETION / OPERATION PERMIT / EXISTING SYSTEM INSPECTION

PROPERTY DESCRIPTION NO. 21032 DATE May 11, '95 TAX MAP NO. pt. of 2CA3 / 4625-59-7886 Watershed: ☑ Yes ☐ No

OWNER OR CONTRACTOR John Wieland Homes PHONE: Business 522-9200 Home

ADDRESS 8325 D Arrowridge Blvd. Suite D, Charlotte, NC

LOCATION Brawley Sch Rd TR Bay Harbor TL LAKE Mist ON Right corner lot w/ Sandpiper

SUBDIVISION The Harbour BLOCK / SECTION 1 LOT 52 LOT AREA ½ Ac SITE CLASS PS pre 1956 DESIGN FLOW 480 gpd L.T.A.R. 3

Septic Tank: 1000 Gallons; STB 294 Oelinger Date 4-19-95

Pump Tank: Gallons; PT Date

Pump Make: Model Serial No.

Nitrification Field: No Fields 1 Square Feet 1200 Linear Feet 400

No Lines 4 Trench Width 36" Max Trench Bottom Depth 36" Gravel Depth N/A

☑ New System ☐ Repair System Type: I, II, III, IV, V, VI

System Description: gravity INFILTRATOR

Repair System Description: Same OR Grav PIPES

Maintenance Agreement Required: ☐ Yes ☑ No

☑ House/Mod. Home ☐ Mobile Home ☐ Business ☐ Other

No. Bedrooms 4 No. Bathrooms 3.5 No. Employees

☐ Slab ☑ Crawl Space ☐ Basement w/plumbing ☐ Basement wo/plumbing


Water Supply: ☐ Individual ☑ Community ☐ Public

Comments: Follow contour w/ laterals


Septic OK'd contingent on the water system being approved. Well head on lot 53. Once the well head is set the temporary well location is to be removed. MK Thomas

Comments:

INITIAL SITE SKETCH

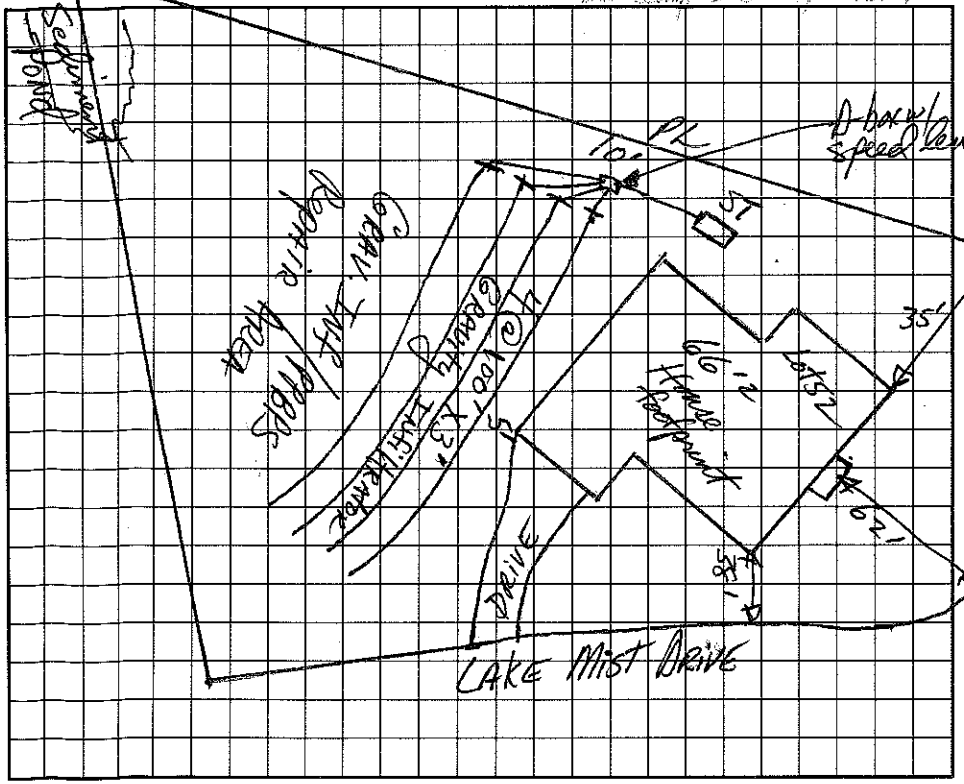

AS BUILT SKETCH

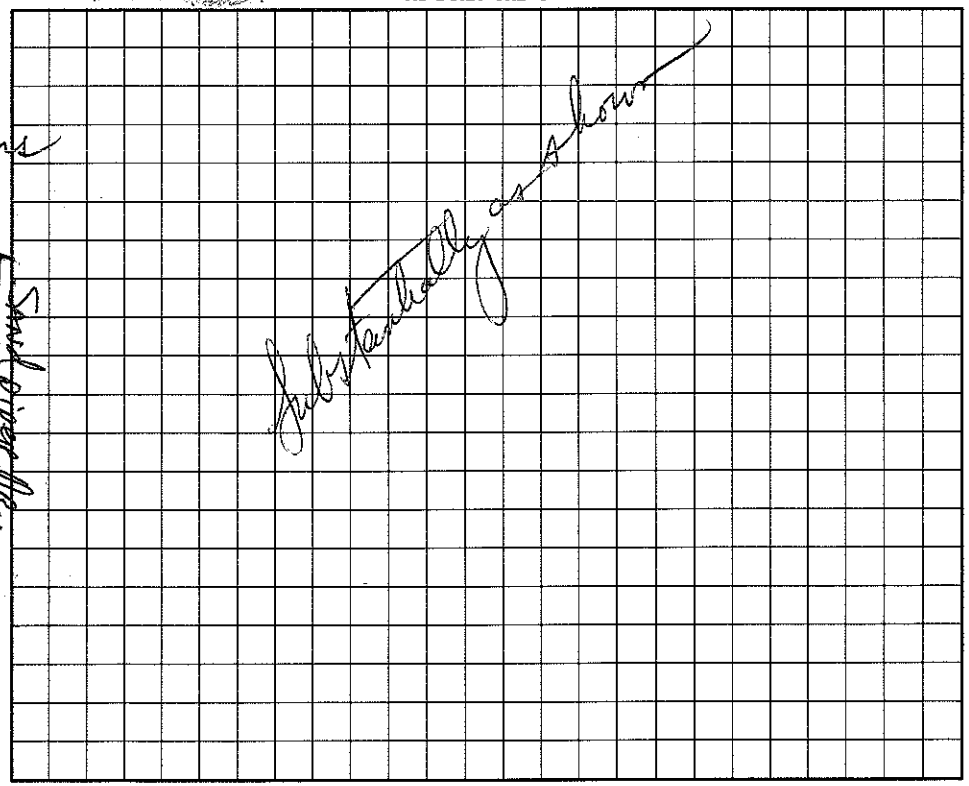

I understand that this permit can be suspended or revoked if any false information is supplied toward securing the permit/any unauthorized changes are made to the site/any unauthorized changes are made in the installation of the system. Improvement Permit is valid for 60 months from date of issuance.

Signed:

Improvement Permit by: Parker R. Johnson, RS date 5/11/95

Existing System Inspection by: date

Installed by: R&R MacLeod

Certificate of Completion by: date

Operation Permit by: Parker R. Johnson, RS date 6-20-95

HEALTH DEPT. COPY: WHITE INSPECTION COPY (FINAL): GREEN OWNER COPY (FINAL): YELLOW INSPECTION COPY (INITIAL): PINK OWNER COPY (INITIAL): GOLD