IREDELL COUNTY HEALTH DEPARTMENT

STATESVILLE 704-878-5305 MOORESVILLE 704-664-5281

IMPROVEMENT PERMIT / AUTHORIZATION TO CONSTRUCT / OPERATION PERMIT / EXISTING SYSTEM INSPECTION

PERMIT# 24424 PIN# 2C-A-3 Pt of 4625-59-9047 DATE 12/17/98

OWNER OR CONTRACTOR John Wieland PHONE: Business 663-6905 Home

ADDRESS 8325 Arrowridge Blvd. Chas. 28273

LOCATION 1100' TR Bay Harbour, TL Lake Mist Drive, 2 lot on (L) of Sec. 2

SUBDIVISION Harbour BLOCK / SECTION 2 LOT 2 LOT AREA ±.9Ac SITE CLASS PS DESIGN FLOW 480 L.T.A.R. .3

Septic Tank: 1000 Gallons; STB 794 Date 9/3/98
Pump Tank: 1000 Gallons; PT Date
Pump Make: HYDROMATIC Model 5K60M1 Serial No. 10-98
Nitrification Field: No Fields 1 Square Feet 1260 Linear Feet 420
No Lines @ 6 Trench Width 36" Max Trench Bottom Depth 36" Gravel Depth SAND

[X] New System [ ] Repair System Type: I, II, (III) IV, V, VI
System Description: PresMan — Ch. Plastic
Repair System Description: 16" PPBS
Maintenance Agreement Required: [X] Yes [ ] No


[X] House/Mod. Home No. Bedrooms 4
[ ] Mobile Home No. Bathrooms 4
[ ] Business No. Employees
[ ] Other
[ ] Slab [X] Crawl Space [ ] Basement w/plumbing [ ] Basement wo/plumbing

Water Supply: [ ] Individual [ ] Public [X] Community


Comments:/Conditions: Change Measurement Due to Relocation of house prior to approval by H.D.

Comments:/Conditions:

INITIAL SITE SKETCH

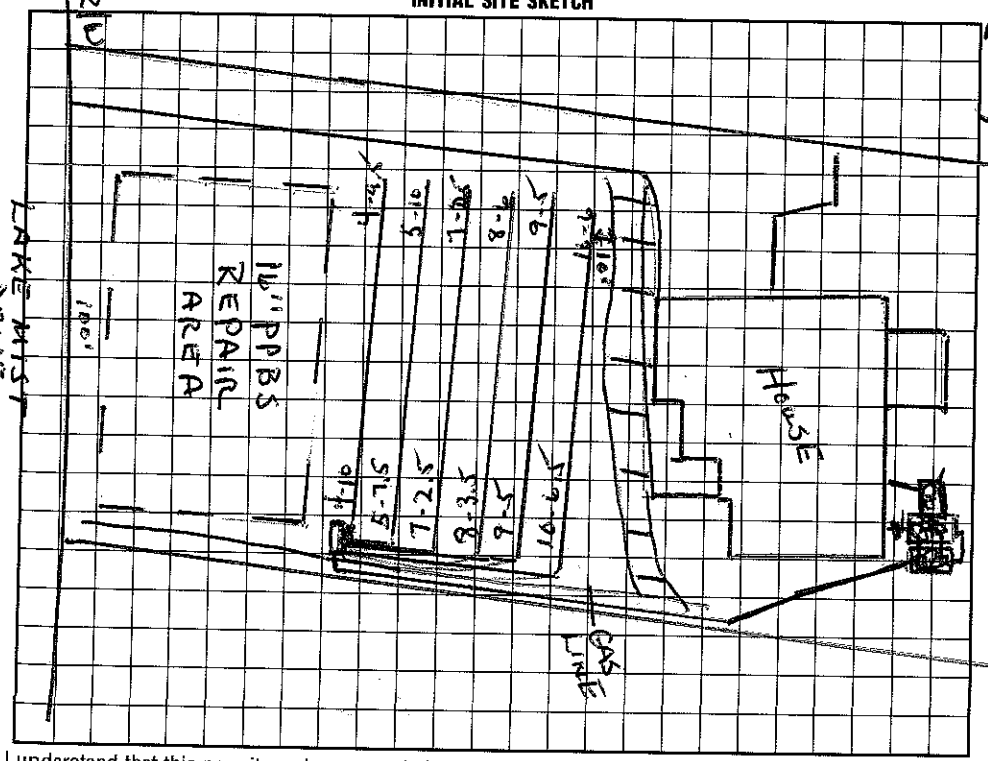

AS BUILT SKETCH

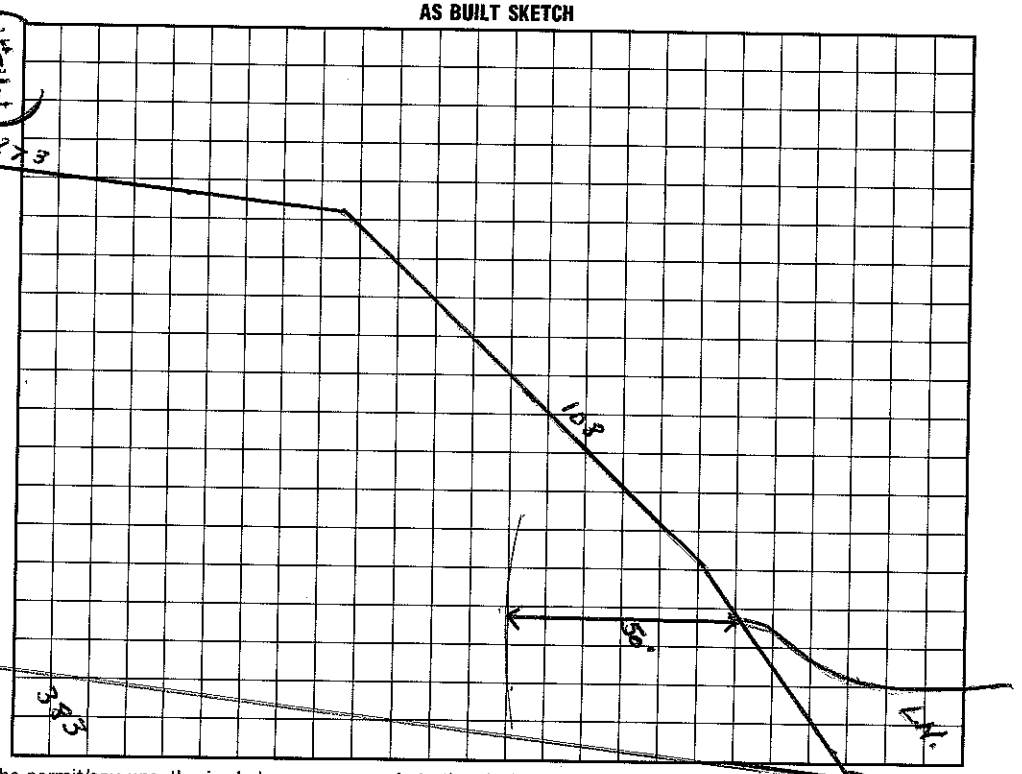

I understand that this permit can be suspended or revoked if any false information is supplied toward securing the permit/any unauthorized changes are made to the site/any unauthorized changes are made in the installation of the system. Improvement Permit with plat valid without expiration. Improvement Permit with site plan valid for sixty months. Authorization to Construct is valid for a period equal to that of Improvement Permit – not to exceed sixty months.

Signed: * Tony Upchurch, REHS Agent date 12/16/98

Improvement Permit by: date

Authorization to Construct by: Wesley Sparks RS. date 12/17/98

Installed by: MacLeod Const.

Operation Permit by: Wesley Sparks RS. date 3/24/99

Existing System Inspection by: date

HEALTH DEPT. COPY: WHITE INSPECTION COPY (FINAL): GREEN OWNER COPY (FINAL): YELLOW INSPECTION COPY (INITIAL): PINK OWNER COPY (INITIAL): GOLD