IREDELL COUNTY HEALTH DEPARTMENT

Suggestion to Construct

STATESVILLE 704-878-5305 MOORESVILLE 704-664-5281

IMPROVEMENT PERMIT / ~~CERTIFICATE OF COMPLETION~~ / OPERATION PERMIT / EXISTING SYSTEM INSPECTION

PROPERTY DESCRIPTION NO. 23280 DATE 3/28/96 TAX MAP NO. 2E 12A 14 Watershed: [X] Yes [ ] No

OWNER OR CONTRACTOR John Wieland Homes PHONE: Business 522-9200 ~~Home~~ 4625-59-9766

ADDRESS 8325-D Arrowridge Blvd. Charlotte, NC 28273

LOCATION Bay Port Ln., 1100' TR Bay Harbour Tr. to Lake Mist Tr. Bay Port, corner lot on (L)

SUBDIVISION Bay Harbour BLOCK / SECTION UNAB LOT 14 LOT AREA .70 AC SITE CLASS. PS DESIGN FLOW 360 L.T.A.R. .325

Septic Tank: 1000 Gallons; STB 744 Date 6/27/96

Pump Tank: _____ Gallons; PT _____ Date _____

Pump Make: _____ Model _____ Serial No. _____

Nitrification Field: No Fields 1 Square Feet 1107 Linear Feet 275*

No Lines 4 Trench Width 36" Max Trench Bottom Depth 36" Gravel Depth 6"STONE

[X] New System [ ] Repair System Type: I, II, (III), IV, V, VI

System Description: * Chem. Plastic

Repair System Description: Chem Plastic

Maintenance Agreement Required: [ ] Yes [ ] No

[X] House/Mod. Home No. Bedrooms 3

[ ] Mobile Home No. Bathrooms 3.5

[ ] Business No. Employees ____

[ ] Other _____


[ ] Slab [X] Crawl Space [ ] Basement w/plumbing [ ] Basement wo/plumbing

Water Supply: [ ] Individual [X] Community [ ] Public

Comments: *

Comments:

INITIAL SITE SKETCH

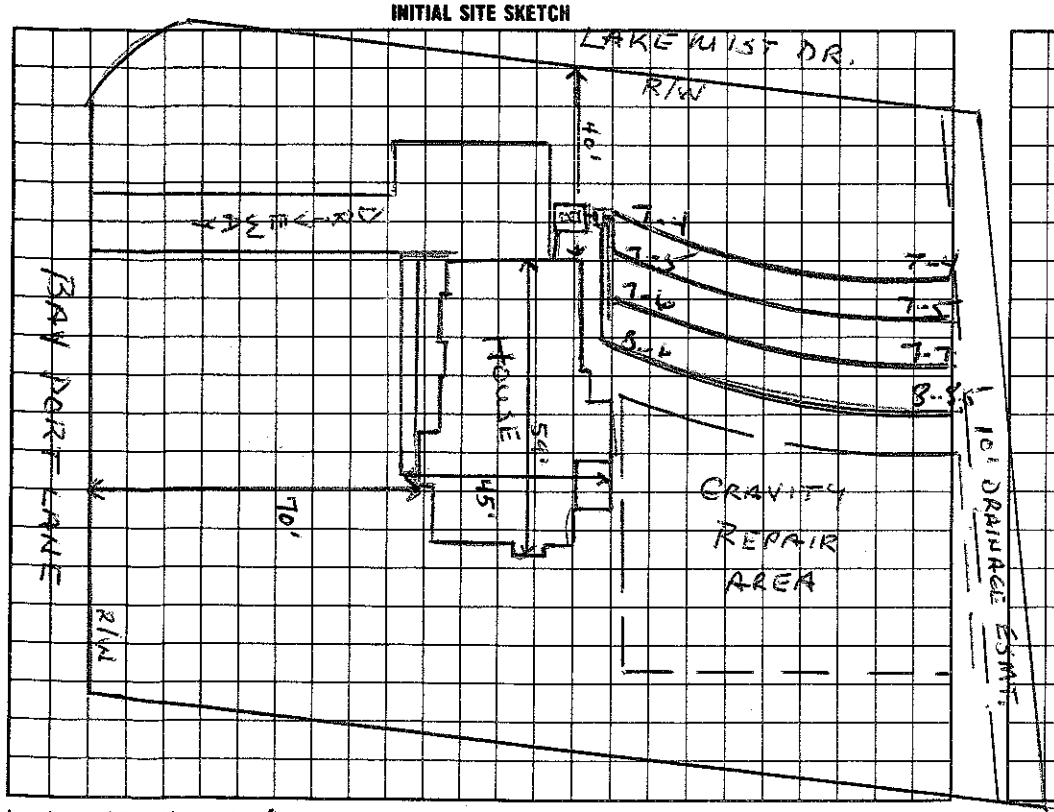

AS BUILT SKETCH

I understand that this permit can be suspended or revoked if any false information is supplied toward securing the permit/any unauthorized changes are made to the site/any unauthorized changes are made in the installation of the system.

Authorization to construct valid for 5 years.

Signed: John Daigle 4/17/96

Improvement Permit by: Wesley Sparks R.S. date 3/28/96

Construction Inspection by: Wesley Sparks R.S. date 3/28/96

Installed by: Mechanical Const. Co.

Certificate of Completion by: Wesley Sparks date 2/26/97

Operation Permit by: Wesley Sparks R.S. date 2/26/97

HEALTH DEPT. COPY: WHITE INSPECTION COPY (FINAL): GREEN OWNER COPY (FINAL): YELLOW INSPECTION COPY (INITIAL): PINK OWNER COPY (INITIAL): GOLD