IREDELL COUNTY HEALTH DEPARTMENT

STATESVILLE 704-878-5305 MOORESVILLE 704-664-

IMPROVEMENT PERMIT / AUTHORIZATION TO CONSTRUCT / OPERATION PERMIT / EXISTING SYSTEM INSPECTION

PERMIT# 114561 PIN# 4625717476.4 Tax 4625604254 DATE 10-19-04

OWNER OR CONTRACTOR Kingswood Homes PHONE: Business 309-4575 Home

ADDRESS 2214 Brawley School Rd Mooresville, NC

LOCATION Brawley School Tr New Haven TR Lynnfield on Lt Corner 109 Lynnfield Ct.

SUBDIVISION Pennt BLOCK / SECTION 12 LOT 1204 LOT AREA 53613 ft² SITE CLASS. PS DESIGN FLOW 600gpd L.T.A.R. .25

Septic Tank: 1500 Gallons; STB 358 Date 12/2/04

Pump Tank: 1500 Gallons; PT 477 Date 12/11/04

Pump Make: Model Serial No.

Nitrification Field: No Fields 1 Square Feet 1800' Linear Feet 600'

No Lines 5 @ 120' Trench Width 36" Max Trench Bottom Depth 36" Gravel Depth N/A

☒ New System ☐ Repair System Type: I, II, III, IV, V, VI

System Description: Pump - 25% Reduction

Repair System Description: LP Panel

Maintenance Agreement Required: ☐ Yes ☒ No Not Initially

☒ House/Mod. Home ☐ Mobile Home ☐ Business ☐ Other

No. Bedrooms 5 No. Bathrooms 4 No. Employees


☐ Slab ☒ Crawl Space ☐ Basement w/plumbing ☐ Basement wo/plumbing

Water Supply: ☐ Individual ☒ Public ☒ Community


Comments/Conditions: Scale 1:50

Comments/Conditions: 2/23/11 Added 1/2 Bath

INITIAL SITE SKETCH

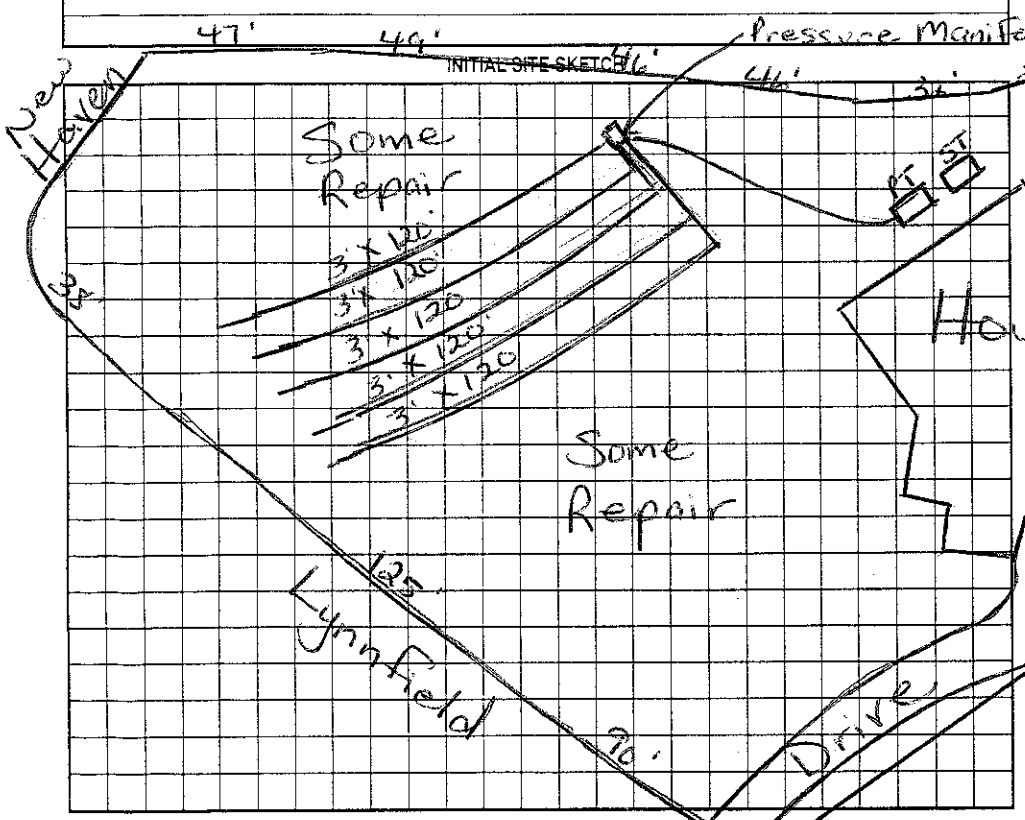

AS BUILT SKETCH

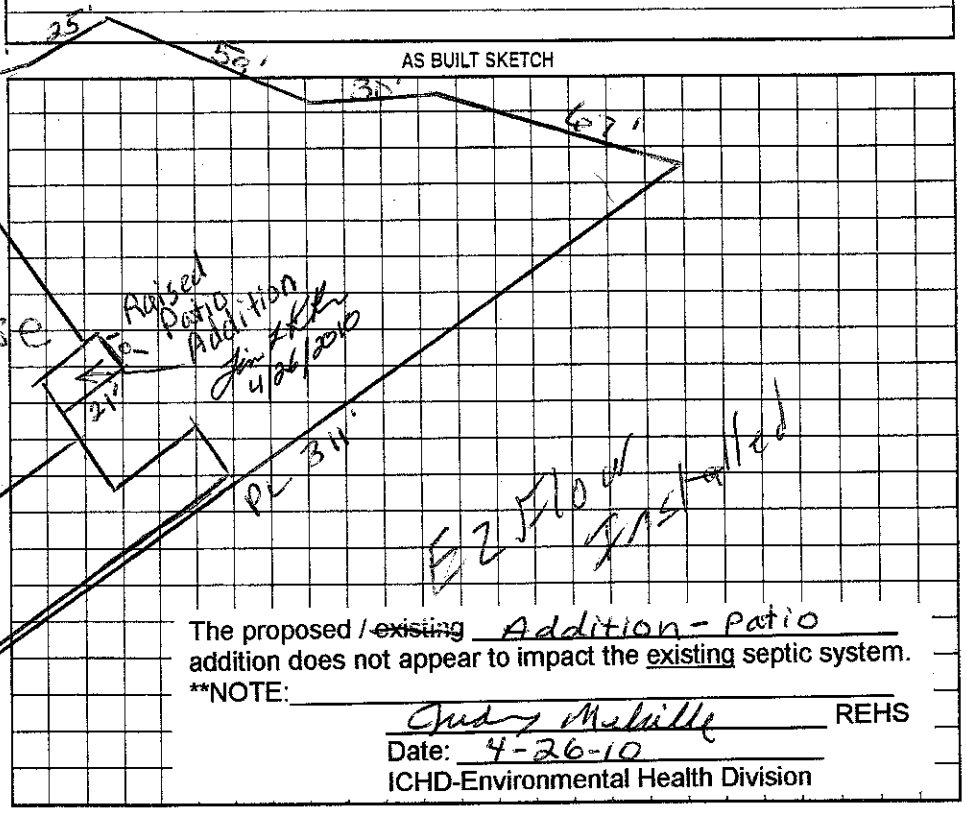

The proposed / ~~existing~~ Addition - Patio addition does not appear to impact the existing septic system.

**NOTE:

Cindy Melville REHS

Date: 4-26-10

ICHD-Environmental Health Division

Permit can be suspended or revoked if any false information is supplied toward securing the permit/any unauthorized changes are made to the site/any unauthorized changes are made in the installation of the system. Improvement Permit with ~~plat~~ valid without expiration. Improvement Permit with site plan valid for sixty months. Authorization to Construct is valid for a period equal to that of Improvement Permit – not to exceed sixty months.

Signed: date 12/14/04 Installed by: Hallman Const

Improvement Permit by: Myra H. Dalton RS date 10/19/04 Operation Permit by: Wesley Sparks R.S. date 3/2/05

Authorization to Construct by: Myra H. Dalton RS date 10/19/04 Existing System Inspection by: date

HEALTH DEPT. COPY: WHITE OWNER COPY (FINAL): YELLOW OWNER COPY (INITIAL): PINK