IREDELL COUNTY HEALTH DEPARTMENT

STATESVILLE 704-878-5305 MOORESVILLE 704-664-

IMPROVEMENT PERMIT / AUTHORIZATION TO CONSTRUCT / OPERATION PERMIT / EXISTING SYSTEM INSPECTION

PERMIT# 114561 PIN# 4625717476.4 Tax 4625604254 DATE 10-19-04

OWNER OR CONTRACTOR Kingswood Homes PHONE: Business 309-4575 Home

ADDRESS 2214 Brawley School Rd Mooresville, NC

LOCATION Brawley School Tr New Haven TR Lynnfield on Lt Corner 109 Lynnfield Ct.

SUBDIVISION Penny BLOCK / SECTION 12 LOT 120A LOT AREA 53613 ft² SITE CLASS. PS DESIGN FLOW 600gpd L.T.A.R. .25

Septic Tank: 1500 Gallons; STB 338 Date 12/12/04

Pump Tank: 1500 Gallons; PT 477 Date 12/11/04

Pump Make: Model Serial No.

Nitrification Field: No Fields 1 Square Feet 1800' Linear Feet 600'

No Lines 5 @ 120' Trench Width 36" Max Trench Bottom Depth 36" Gravel Depth N/A

[X] New System [ ] Repair System Type: I, II, III, IV, V, VI

System Description: Pump - 25% Reduction

Repair System Description: LP Panel

Maintenance Agreement Required: [ ] Yes [X] No Not Initially

[X] House/Mod. Home [ ] Mobile Home [ ] Business [ ] Other


No. Bedrooms 5 No. Bathrooms 4 No. Employees

Water Supply: [ ] Individual [X] Public [X] Community

[ ] Slab [X] C

Comments/Conditions: Scale 1:50

INITIAL SITE SKETCH

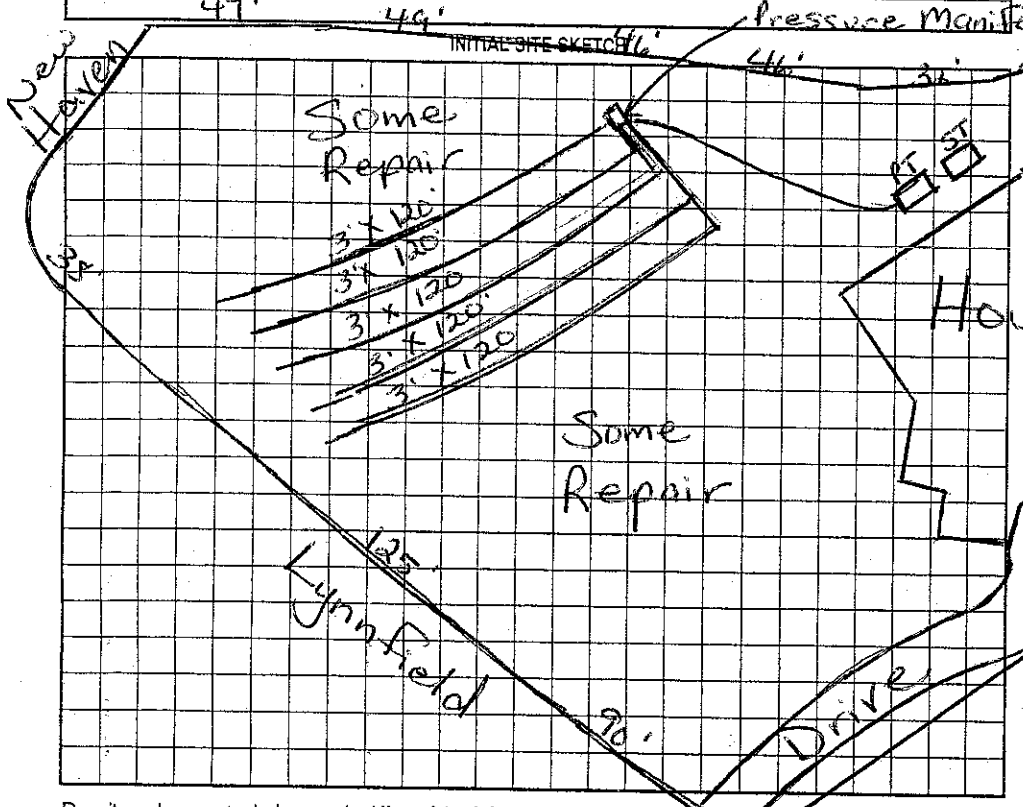

Comments/Conditions: Doesn't change # of Bedrooms

The location of the proposed 1/2 Bath addition does not appear to impact the existing septic system.


**NOTE: Bathroom within original footprint

Maria H Dotson REHS

Date: 2/23/11

ICHD-Environmental Health Division

AS BUILT SKETCH

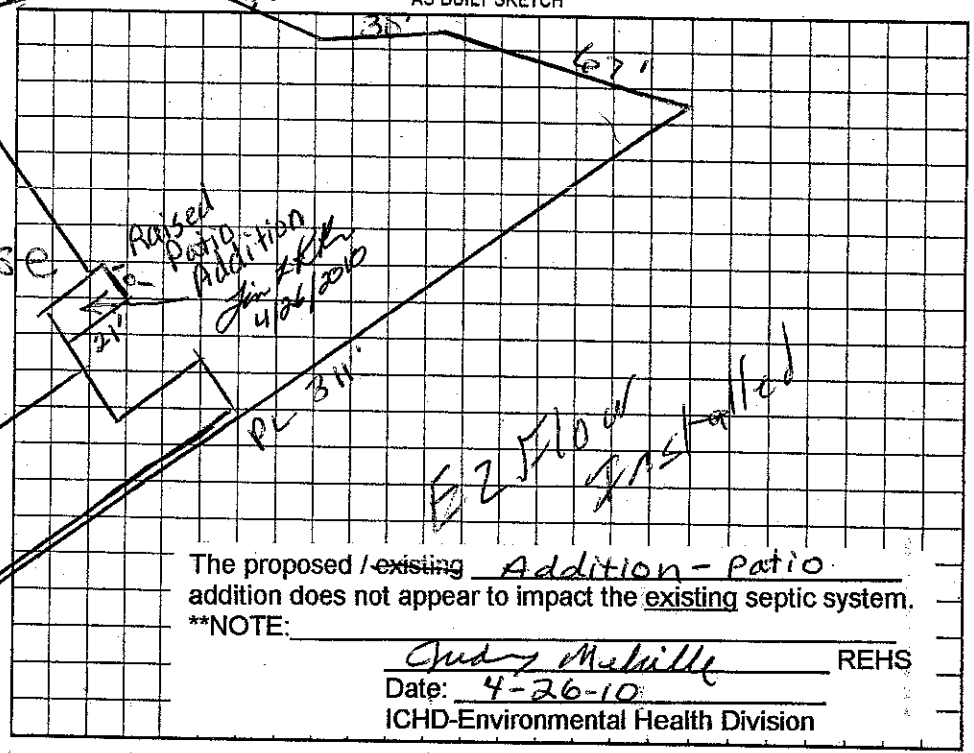

The proposed / ~~existing~~ Addition - Patio addition does not appear to impact the existing septic system.

**NOTE:

Cindy Melville REHS

Date: 4-26-10

ICHD-Environmental Health Division

Permit can be suspended or revoked if any false information is supplied toward securing the permit/any unauthorized changes are made to the site/any unauthorized changes are made in the installation of the system. Improvement Permit with plat valid without expiration. Improvement Permit with site plan valid for sixty months. Authorization to Construct is valid for a period equal to that of Improvement Permit – not to exceed sixty months.

Signed: date 12/14/04 Installed by: Hall Mgn Const

Improvement Permit by: Maria H Dotson RS date 10/19/04 Operation Permit by: Wesley Sparks RS date 3/2/05

Authorization to Construct by: Maria H Dotson RS date 10/19/04 Existing System Inspection by: date

HEALTH DEPT. COPY: WHITE OWNER COPY (FINAL): YELLOW OWNER COPY (INITIAL): PINK