IREDELL COUNTY HEALTH DEPARTMENT

STATESVILLE 704-878-5305 MOORESVILLE 704-664-5281

IMPROVEMENT PERMIT / AUTHORIZATION TO CONSTRUCT / OPERATION PERMIT / EXISTING SYSTEM INSPECTION

PERMIT # 175891 PIN # 4625097663 DATE 12-6-12

OWNER or APPLICANT Avalon Custom Building Group PHONE: Business 704-202-4390 Home: N/A

OWNER or APPLICANT ADDRESS 233 Brenwood Dr. Charlotte

LOCATION / DIRECTIONS Brawley School Rd. TR Chockwood Rd TL Barber LP TL Old Arboway Rd.

SUBDIVISION C.L.T. BLOCK / SECTION 57 LOT # 143 LOT AREA 1.13 acres DESIGN FLOW 360 gpd L.T.A.R. 0.3

Septic Tank 1600 Gallons: STB Date

Pump Tank 1000 Gallons: PT Date

Pump Make Model Serial #

Nitrification Field No Fields 1 No Lines 4 Linear Feet 200

Trench Width 24" Max. Trench Bottom Depth 36" Gravel Depth N/A ☐ GRAVITY ☑ PRESSURE

☑ New System ☐ Repair ☐ Expansion System Type I II III IV V VI

System Description: PPBPS - Pressure manifold

Repair System Description: Low Pressure PPBPS

Maintenance Agreement Required ☐ YES ☑ NO


☑ Residence No. Bedrooms 3 ☐ Business No. Persons ☐ Other No. Employees ☐ Slab ☑ Crawl Space ☐ Basement w/plumbing ☐ Basement w/o plumbing

Water Supply: ☑ Private ☐ Public ☐ Community


Comments / Conditions: Install a Panel block system on contour with Parallel distribution; 12 panels per line; Supply line shall be 30" deep at all points under driveway or encased in ductile iron.

Comments / Conditions: Pump & crush existing septic tank

INITIAL SITE SKETCH

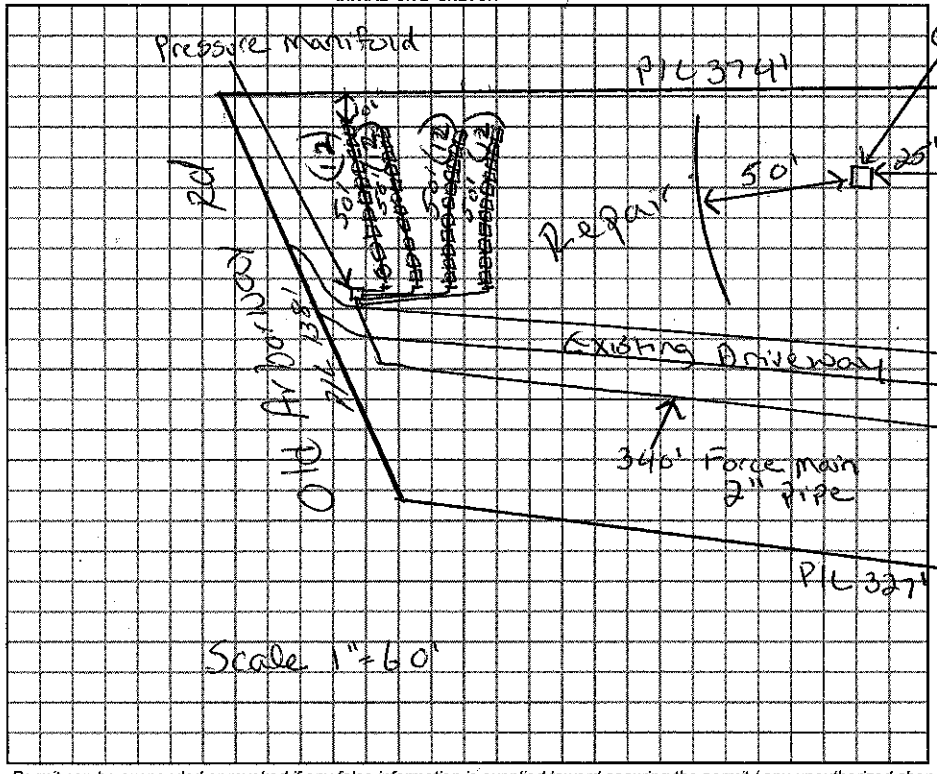

AS BUILT SKETCH

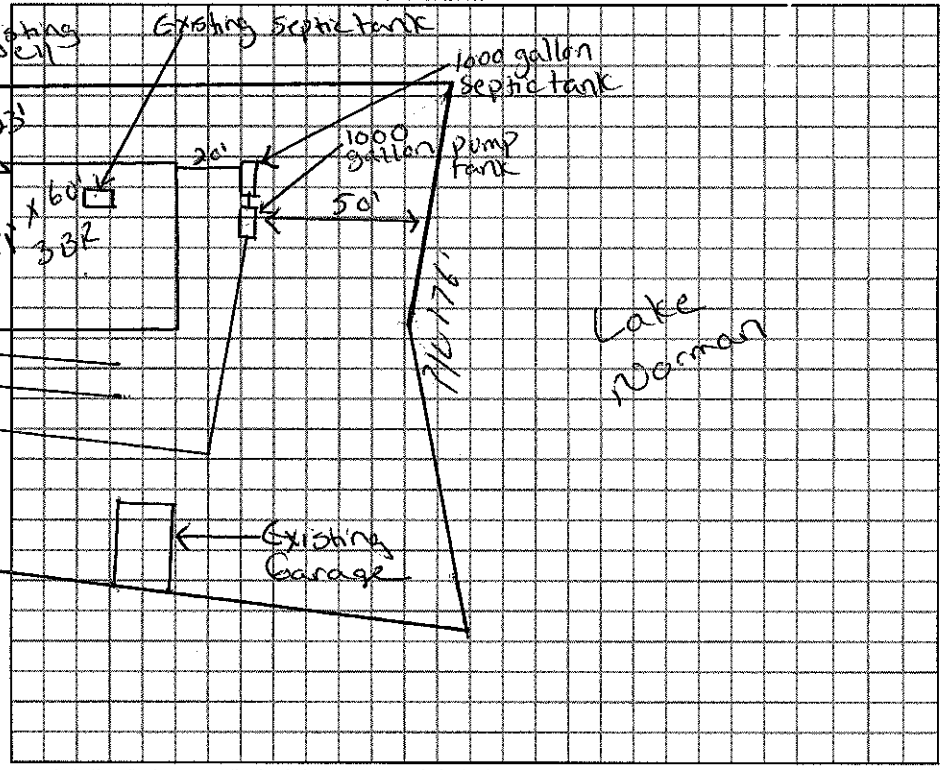

Permit can be suspended or revoked if any false information is supplied toward securing the permit / any unauthorized changes are made to the site / any unauthorized changes are made in the installation of the system.

☐ *IMPROVEMENT PERMIT w / plan valid without expiration.* ☐ *IMPROVEMENT PERMIT w / site plan valid for 60 mos.* ☑ *AUTHORIZATION TO CONSTRUCT valid for period equal to IMPROVEMENT PERMIT-not to exceed 60 mo.*

Owner / Applicant Signature: Date 12/12/12

Improvement Permit by: Justin Henderson Date 12-6-12

Authorzation to Construct by: Justin Henderson Date 12-6-12

YOU SHOULD CONTACT A LOCATOR SERVICE PRIOR TO ANY EXCAVATION.

Installed by:

Operation Permit by: Date:

Existing System Inspected by: Date:

WHITE COPY Environmental Health YELLOW COPY (Final) Owner / Applicant PINK COPY (Initial) Owner / Applicant