$100 2150

IREDELL COUNTY HEALTH DEPARTMENT

STATESVILLE 704-878-5305 MOORESVILLE 704-664-5281

IMPROVEMENT PERMIT / AUTHORIZATION TO CONSTRUCT / OPERATION PERMIT / EXISTING SYSTEM INSPECTION

PERMIT# 114670 PIN# ~~4625 11 7446.29~~ 4625 00 7513 DATE 6/17/06

OWNER OR APPLICANT Augusta Homes PHONE: Business _____ Home _____

ADDRESS _____

LOCATION BSR, TL New Haven on Lt

SUBDIVISION The Point BLOCK / SECTION 12 LOT 1229 LOT AREA 63,183 Ft² SITE CLASS. PS DESIGN FLOW 600 L.T.A.R. 0.3

Septic Tank: 1500 Gallons; STB 338 Date 4-30-07
Pump Tank: _____ Gallons; PT _____ Date _____
Pump Make: _____ Model _____ Serial No. _____
Nitrification Field: No Fields 1 Square Feet 1500 Linear Feet 500
No Lines 5 @ 100' Trench Width 30" Max Trench Bottom Depth 36"

☒ New System ☐ Repair ☐ Expansion System Type: I (II) III IV V VI
System Description: 25% Reduction
Repair System Description: Same
Maintenance Agreement Required: ☐ Yes ☒ No

☒ House/Mod. Home No. Bedrooms 5
☐ Mobile Home No. Persons ____
☐ Business No. Employees ____
☐ Other ____

Water Supply: ☐ Individual ☐ Public ☒ Community


Gravel Depth — ☒ Gravity ☐ Pressure ☐ Slab ☒ Crawl Space ☐ Basement w/plumbing ☐ Basement wo/plumbing

Comments:/Conditions:


Comments:/Conditions: 6/1/07 Checked ST
6/5/07 Installed EZ-Flow for Drainfield

1"=50'

INITIAL SITE SKETCH

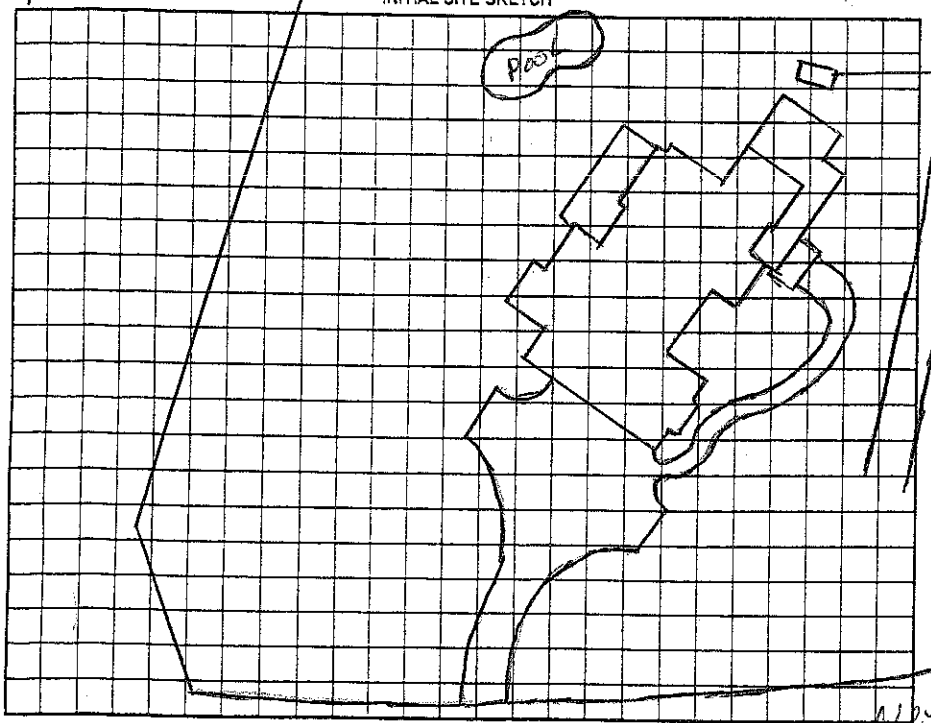

AS BUILT SKETCH

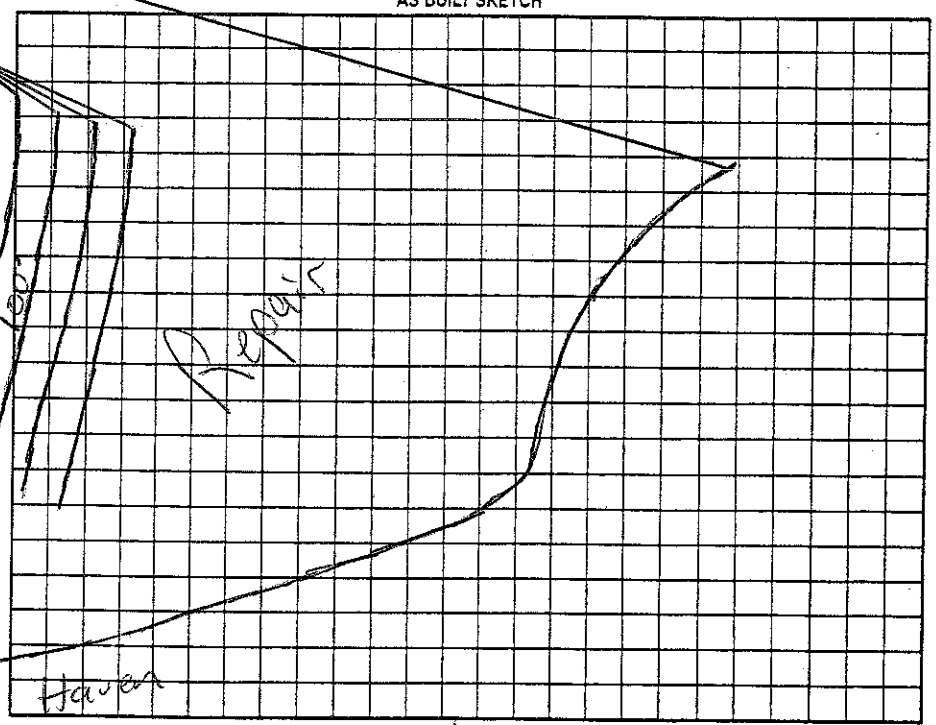

Permit can be suspended or revoked if any false information is supplied toward securing the permit/any unauthorized changes are made to the site/any unauthorized changes are made in the installation of the system. Improvement Permit with plat valid without expiration ☐ Improvement Permit with site plan valid for sixty months ☐ Authorization to Construct is valid for a period equal to that of Improvement Permit – not to exceed sixty months.

Signed: _____ date 6/19/06
Improvement Permit by: _____ date 6/19/06
Authorization to Construct by: _____ date 6/17/06

Installed by: R & R
Operation Permit by: _____ date 6/5/07
Existing System Inspection by: _____ date _____

HEALTH DEPT. COPY: WHITE OWNER COPY (FINAL): YELLOW OWNER COPY (INITIAL): PINK