...LL COUNTY HEALTH DEPARTMENT

STATESVILLE 704-878-5305 MOORESVILLE 704-664-5281

...OVEMENT PERMIT / AUTHORIZATION TO CONSTRUCT / OPERATION PERMIT / EXISTING SYSTEM INSPECTION

114668 PIN# ~~4625 71 74 76 27~~ 4625 08 86 63 DATE 9/17/03

OWNER OR CONTRACTOR POINT ON NORMAN / Kingswood PHONE: Business 660-1185 Home

ADDRESS 2214 BRAWLEY SCHOOL MOORESVILLE NC 28117

LOCATION BRAWLEY SCHOOL - TL NEW HAVEN - TL NORTH LONGFELLOW AT END ON LT

SUBDIVISION POINT BLOCK / SECTION 12 LOT 27 LOT AREA 55,723 ft² SITE CLASS. PS DESIGN FLOW 480 GPD L.T.A.R. .30-00/KT2

Septic Tank: ~~1000~~ 1500 Gallons; STB 338 Date 2/20/06

Pump Tank: ~~1000~~ Gallons; PT Date

Pump Make: Model Serial No.

Nitrification Field: No Fields 1 Square Feet 1200 Linear Feet 400

No Lines 3 @ 133' Trench Width 36" Max Trench Bottom Depth 36" Gravel Depth N/A

☑ New System ☐ Repair System Type: I, II, (III), IV, V, VI

System Description: GRAVITY 25% REDUCTION

Repair System Description: LP PANEL

Maintenance Agreement Required: ☐ Yes ☑ ~~No~~

☑ House/Mod. Home No. Bedrooms 4

☐ Mobile Home No. Bathrooms 4

☐ Business No. Employees

☐ Other


☐ Slab ☑ Crawl Space ☐ Basement w/plumbing ☐ Basement wo/plumbing

Water Supply: ☐ Individual ☐ Public ☑ ~~Community~~


Comments:/Conditions:
10/20/05 Reviewed Building plans, essentially in compliance with original permit.

Comments:/Conditions: EZ FLOW
Tank & lines checked by AWS 4/15/06
D-box & Speed levelers checked 6/6/06

INITIAL SITE SKETCH

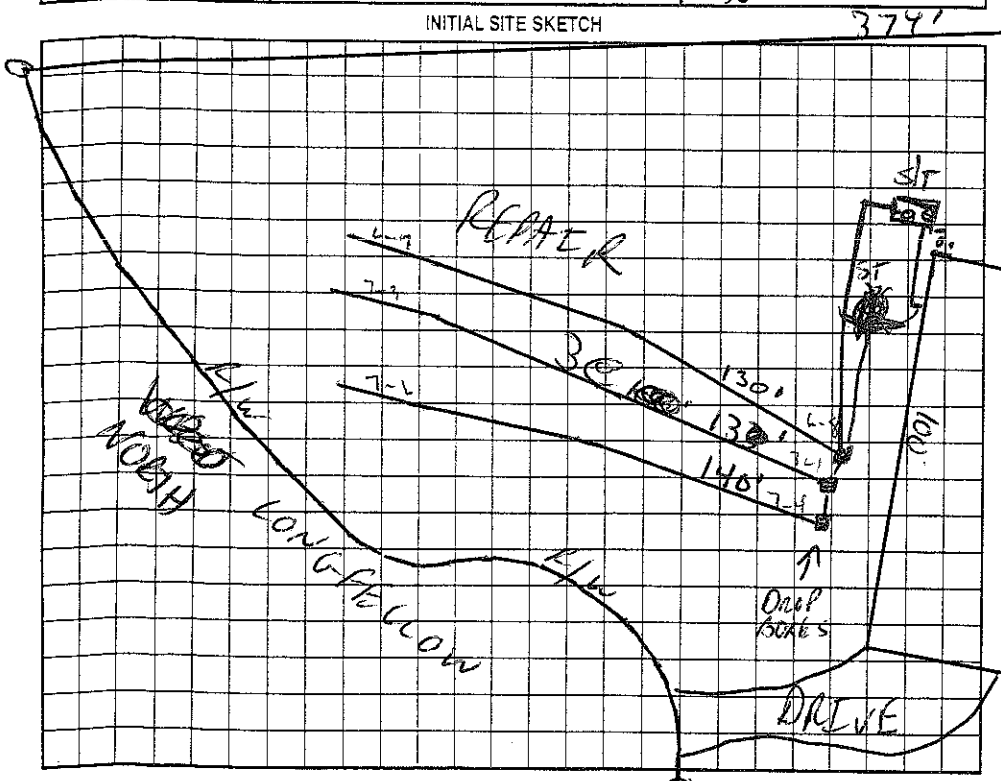

AS-BUILT SKETCH

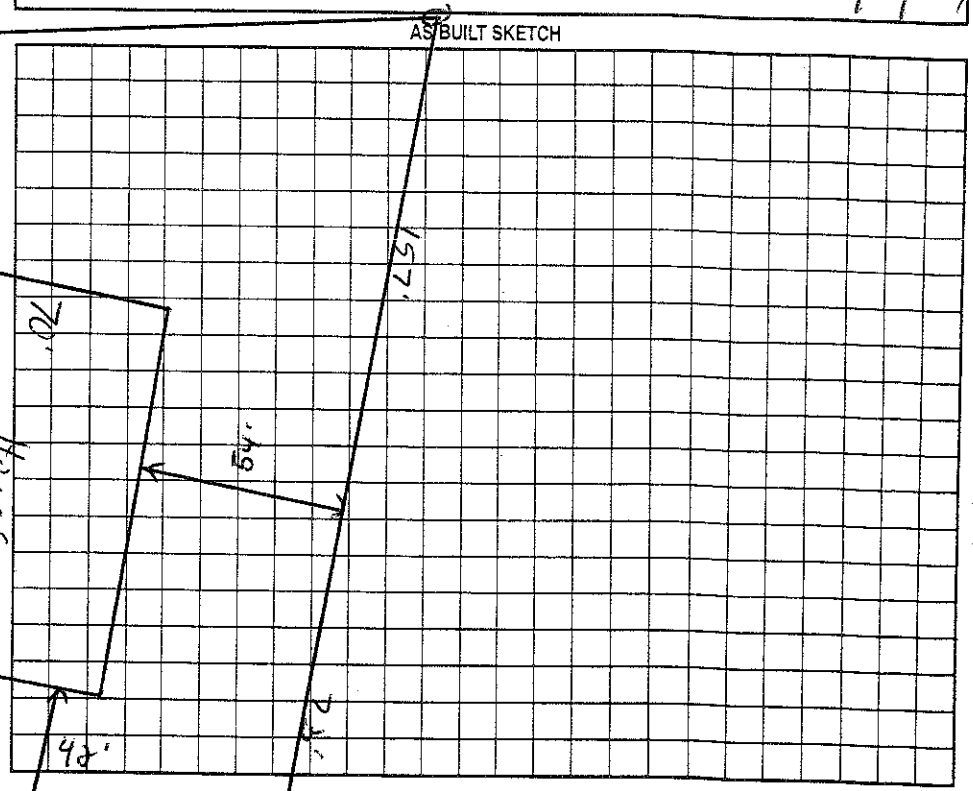

Permit can be suspended or revoked if any false information is supplied toward securing the permit/any unauthorized changes are made to the site/any unauthorized changes are made in the installation of the system. Improvement Permit with plat valid without expiration. Improvement Permit with site plan valid for sixty months. Authorization to Construct is valid for a period equal to that of Improvement Permit – not to exceed sixty months.

Signed: date 2-23-06

Improvement Permit by: KS date 9/17/03

Authorization to Construct by: Melissa Dotson RS date 10/20/05

Installed by: Halfpenny Const Co.

Operation Permit by: Melissa Dotson RS date 6/6/06

Existing System Inspection by: date

HEALTH DEPT. COPY: WHITE OWNER COPY (FINAL): YELLOW OWNER COPY (INITIAL): PINK