IREDELL COUNTY HEALTH DEPARTMENT

STATESVILLE 704-878-5305 MOORESVILLE 704-664-5281

IMPROVEMENT PERMIT / AUTHORIZATION TO CONSTRUCT / OPERATION PERMIT / EXISTING SYSTEM INSPECTION

PERMIT# 114563 PIN# 4625 71 7476.6 4625609204 DATE 4/23/05

OWNER OR CONTRACTOR Jenkins Builders PHONE: Business 704-358-9940 Home

ADDRESS 817 E Morehead St. Charlotte, NC. 28202

LOCATION 1100 TL New Haven Ct, on R at circle 108 S. Longfellow Ln

SUBDIVISION Point BLOCK / SECTION 12 LOT 1206 LOT AREA 42,314 SITE CLASS RS DESIGN FLOW 600 L.T.A.R. .3

Septic Tank: 1500 Gallons; STB 338 Date

Pump Tank: 1500 Gallons; PT 283 Date

Pump Make: Goulds Model WE0312 Serial No.

Nitrification Field: No Fields 1 Square Feet 1500 Linear Feet 500

No Lines 7@71 Trench Width 3' Max Trench Bottom Depth 3'

☒ New System ☐ Repair System Type: I, II, (III), IV, V, VI

System Description: PM → 2570 Reduced

Repair System Description: 16" PPBPS

Maintenance Agreement Required: ☐ Yes ☒ No

Gravel Depth NA

☒ House/Mod. Home ☐ Mobile Home ☐ Business ☐ Other

No. Bedrooms 5 No. Bathrooms 4.5 No. Employees

☐ Slab ☒ Crawl Space ☐ Basement w/plumbing ☐ Basement wo/plumbing

Water Supply: ☐ Individual ☐ Public ☒ Community Point


Comments:/Conditions:

Comments:/Conditions:


Checked lines 4/21/05

1" = 50'

INITIAL SITE SKETCH

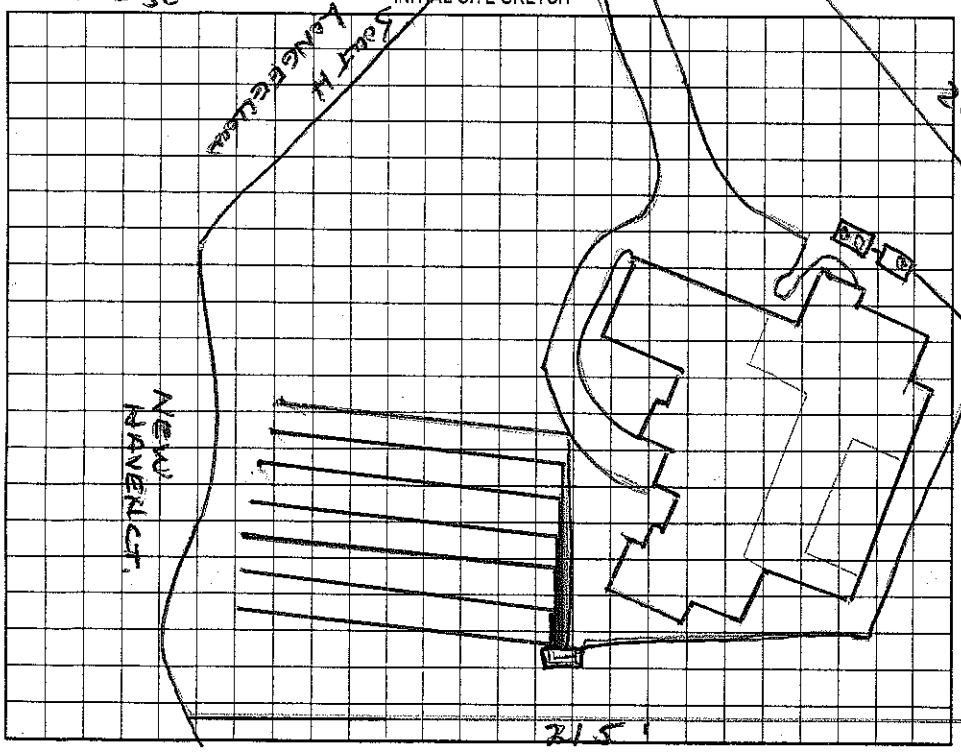

AS BUILT SKETCH

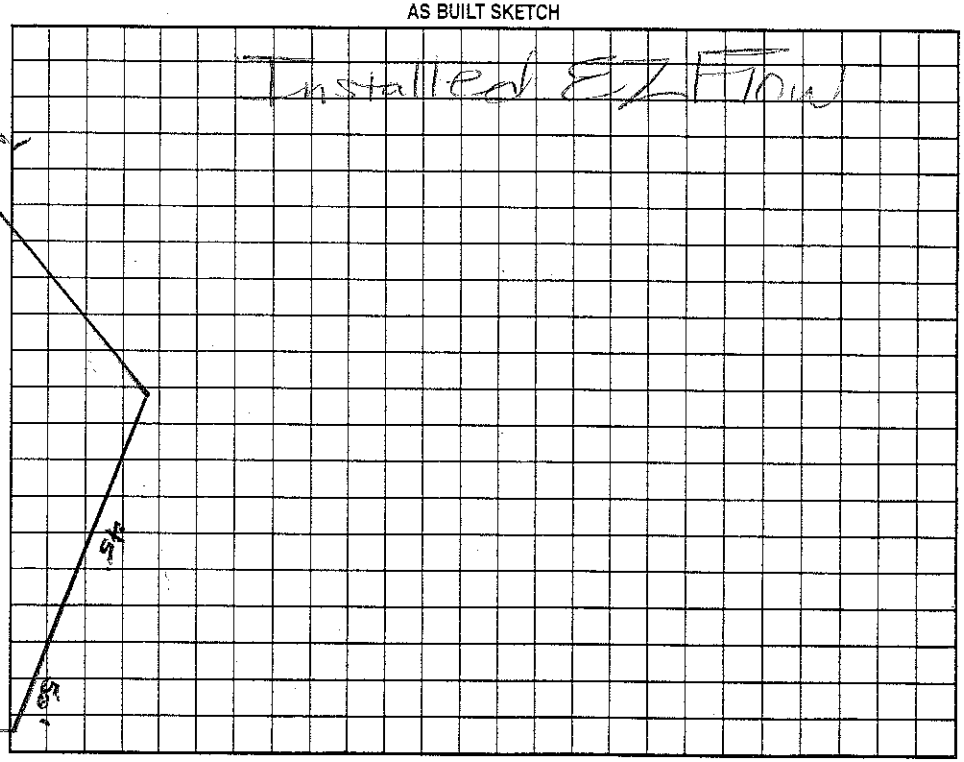

Permit can be suspended or revoked if any false information is supplied toward securing the permit/any unauthorized changes are made to the site/any unauthorized changes are made in the installation of the system. Improvement Permit with plat valid without expiration. Improvement Permit with site plan valid for sixty months. Authorization to Construct is valid for a period equal to that of Improvement Permit – not to exceed sixty months.

Signed: [signature] date 6-30-05 Installed by: R&H RS

Improvement Permit by: Wesley Sparks RS date 4/23/05 Operation Permit by: Marvin H Dotson date 7/13/05

Authorization to Construct by: Wesley Sparks RS date 4/23/05 Existing System Inspection by: date

HEALTH DEPT. COPY: WHITE OWNER COPY (FINAL): YELLOW OWNER COPY (INITIAL): PINK