IREDELL COUNTY HEALTH DEPARTMENT

Statesville Office (704) 878-5305 Mooresville Office (704) 660-3625 PERMIT # 2034660

IMPROVEMENT PERMIT / AUTHORIZATION TO CONSTRUCT / OPERATION PERMIT / EXISTING SYSTEM

PIN # 4625615830

APPLICANT: Whitley Construction APPLICANT ADDRESS: 127 Hunter's Point Mooresville, NC 28117

SITE ADDRESS: 120 Deacons Pond Ct - Mooresville, NC PHONE: 704 658-9251 ALT. PHONE: 704 361 9879

SITE DIRECTIONS: Brawley School Rd TR Heathland TR Deacon's Pond Ct at End - Easement on RSR

SUBDIVISION: The Point on Norman SECTION: 8 LOT # 744/744A LOT AREA: 57,639+31,634 DESIGN FLOW: 600gpd L.T.A.R.: .25 Initial / .1 Repair

Septic Tank 1500 (gal) STB 444 Date 1-9-15
Pump Tank 1500 (gal) PT 477 Date 1-5-15
Pump Make Orenco Model PF 501012 Serial #
Nitrification Fields 1 # Lines 6 Linear Ft: 600ft
Trench Width 36" Max. Trench Bottom Depth 36" Gravel Depth N/A

☒ New System ☐ Repair ☐ Expansion System Type: I II (III) IV V VI
System Description: Pump (Pm) 25% Reduction
Repair System Description: RS-1 Pretreatment Drip
Maintenance Agreement Required: ☐ YES ☒ NO
☐ GRAVITY ☒ PRESSURE

☒ Residence No. Bedrooms 5
☐ Business No. Persons 10
☐ Other No. Employees
☐ Slab ☐ Crawl Space
☒ Basement w/plumbing ☐ Basement w/o plumbing

Water Supply: ☐ Private ☐ Public ☒ Community

Comments / Conditions: 5/29/14 Reviewed Floor plans, In compliance with Septic Plan
3/25/15 Checked tanks and Supply line. Buried > 30"

☆ Septic Drainfield located offsite
OT 12ft off PL
Pressure Manifold at edge of Utility Easement directly in line with Septic Supply line

INITIAL SITE SKETCH

(Off site system)
See attached/approved
plan by S & ME
dated 5/16/2014

AS BUILT SKETCH

5/22/15 Set 2 ft pressure
Checked elect & alarm

Permit can be suspended or revoked if any false information is supplied toward securing the permit / any unauthorized changes are made to the site / any unauthorized changes are made in the installation of the system. **CONTACT A LOCATOR SERVICE PRIOR TO ANY EXCAVATION**

☐ **IMPROVEMENT PERMIT** *with plat valid without expiration.* ☐ **IMPROVEMENT PERMIT** *with site plan valid for 60 mos.* ☐ **AUTHORIZATION TO CONSTRUCT** *valid for period equal to IMPROVEMENT PERMIT--not to exceed 60 mo.*

Owner / Applicant Signature: Date: Installed by: Hallman Construction

IMPROVEMENT PERMIT by: Maria H. Dotson RS Date: 5/27/14 OPERATION PERMIT by: Maria H. Dotson RS Date: 5/22/15


AUTHORIZATION TO CONSTRUCT by: Maria H. Dotson Date: 5/29/14 Existing System Inspected by: Date:

Health Dept. Copy - WHITE Applicant (Final Approval) - YELLOW Applicant (Conditional Approval) - PINK

THE POINT TWA SEPTIC ADDITION

BASE SOUTH SITE PLAN FROM SEPTIC DETAIL PLAN SHEET

* Must Accommodate Septic Tank Replacement Area

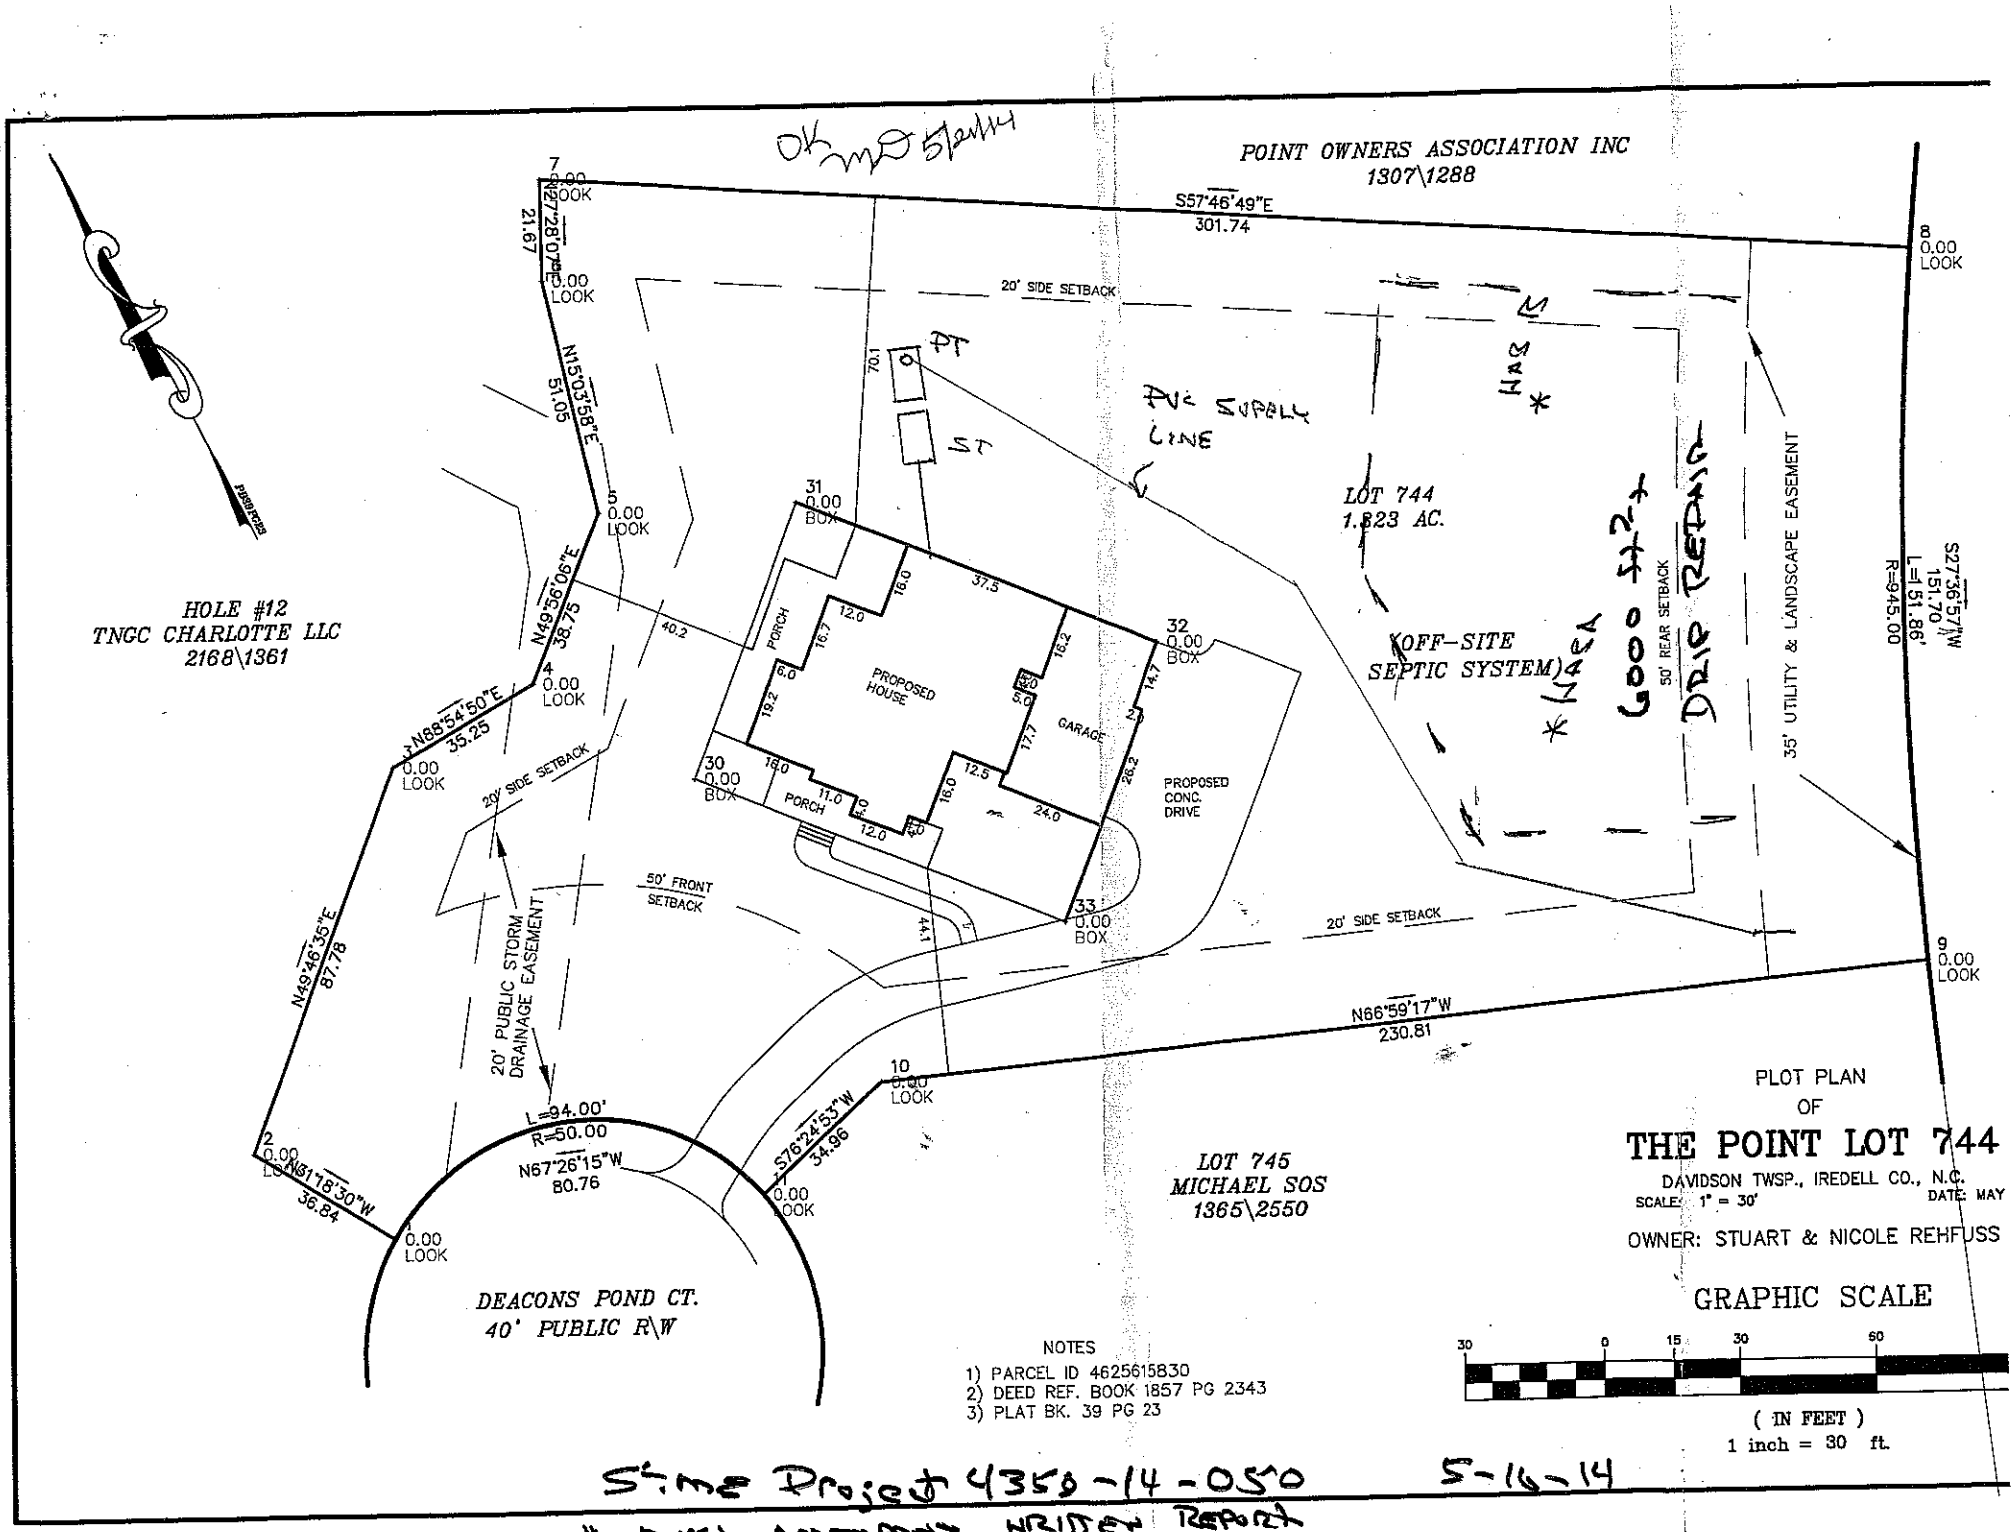

NOTES
1) PARCEL ID 4625615830
2) DEED REF. BOOK 1857 PG 2343
3) PLAT BK. 39 PG 23

PLOT PLAN
OF
THE POINT LOT 744
DAVIDSON TWSP., IREDELL CO., N.C.
SCALE: 1" = 30' DATE: MAY
OWNER: STUART & NICOLE REHFUSS

GRAPHIC SCALE
30 0 15 30 60
(IN FEET)
1 inch = 30 ft.

Site Project 4358-14-050 5-16-14
* must accompany written report