IREDELL COUNTY HEALTH DEPARTMENT

STATESVILLE 704-878-5305 MOORESVILLE 704-664-5281

IMPROVEMENT PERMIT / AUTHORIZATION TO CONSTRUCT / OPERATION PERMIT / EXISTING SYSTEM INSPECTION

PERMIT# 094943 PIN# ~~4625941684~~ (PT) 4625-62-0531 DATE 5/23/02

OWNER OR CONTRACTOR CRESCENT RESOURCES / YOUNG BUILDERS PHONE: Business 895-2912 Home

ADDRESS 18505 STATESVILLE AVE. CORNELIUS NC 28031

LOCATION BRAWLEY SCHOOL - TR ATTLEBORO - TL RATHBOTH - 2nd lot ON RT

SUBDIVISION POINT BLOCK / SECTION 7 LOT 722 LOT AREA 41928 sq ft SITE CLASS. PS DESIGN FLOW 480.00 L.T.A.R. .25 - .3 gpd/sq ft

Septic Tank: 1500+ Gallons; STB 338 Date 1/6/03

Pump Tank: 1000+ Gallons; PT 27 Date 1/13/03

Pump Make: GOULDS Model WE0512H1 Serial No.

Nitrification Field: No Fields 1 Square Feet 640 Linear Feet 320

No Lines 4@80' Trench Width 24-36" Max Trench Bottom Depth 36" Gravel Depth N/A

☑ New System ☐ Repair System Type: I, II, III, (IV), V, VI

System Description: LP PANEL

Repair System Description: SAME

Maintenance Agreement Required: ☑ Yes ☐ No

☐ House/Mod. Home No. Bedrooms 4

☐ Mobile Home No. Bathrooms 4

☐ Business No. Employees

☐ Other


☐ Slab ☑ Crawl Space ☐ Basement w/plumbing ☐ Basement wo/plumbing

Water Supply: ☐ Individual ☑ Public ☐ Community


Comments/Conditions:

Comments/Conditions: 2/26/03 Tanks & lines checked by W.S
3/4/03 Pressure Checked by WS

INITIAL SITE SKETCH 1" = 50'

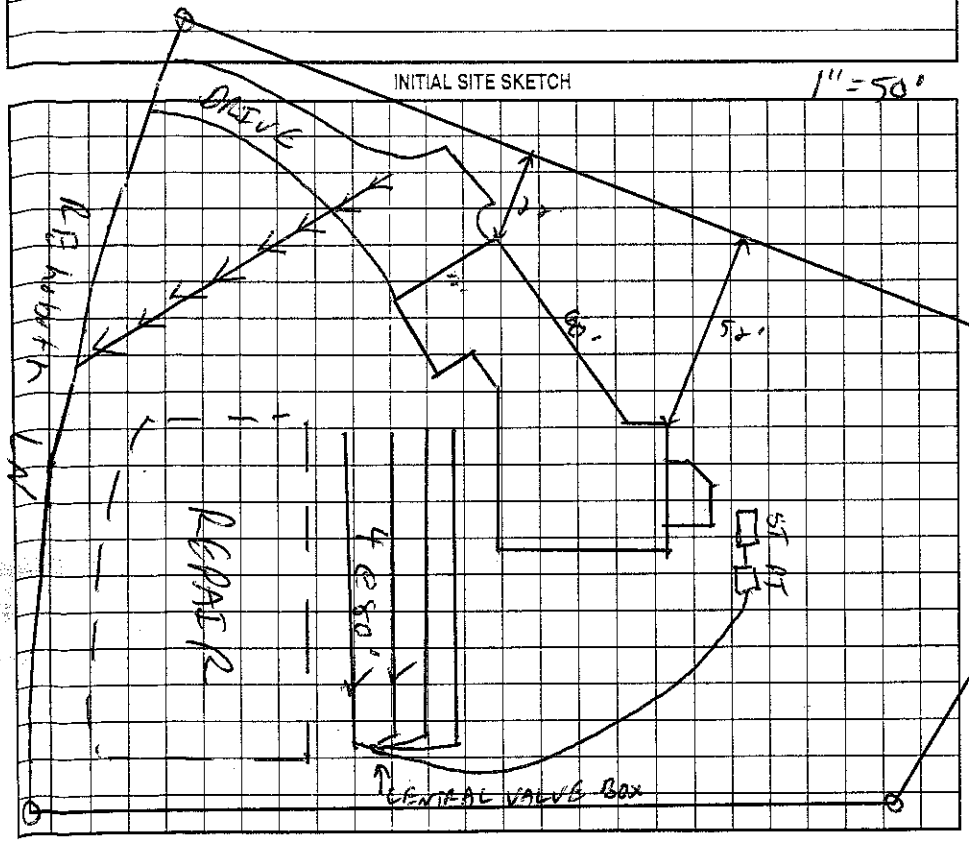

AS BUILT SKETCH

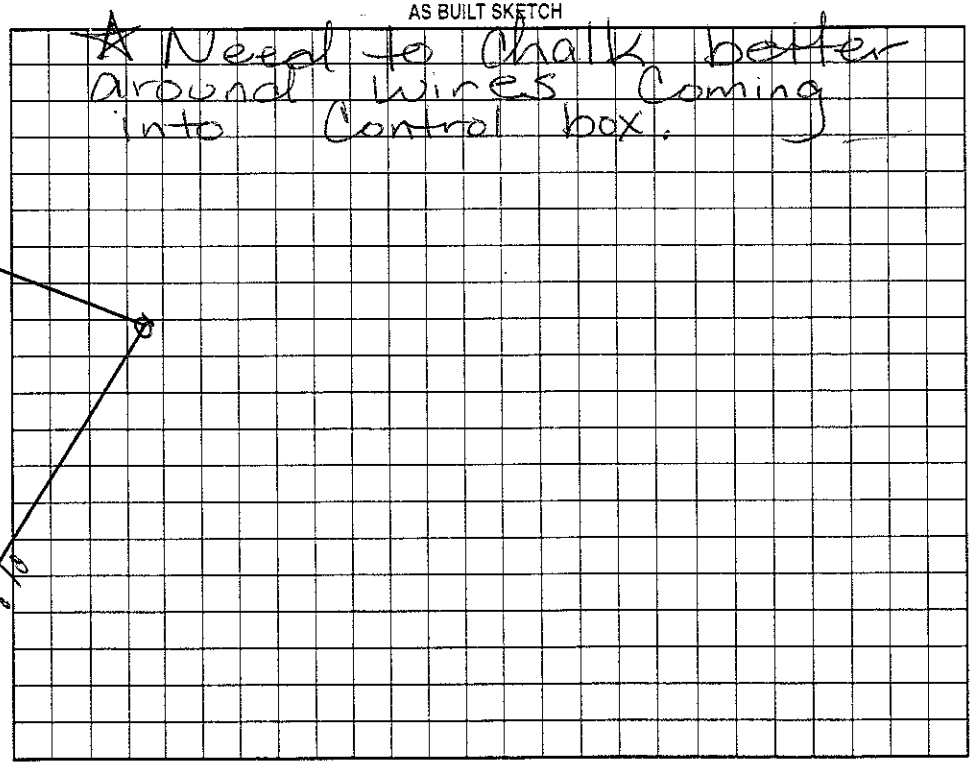

Permit can be suspended or revoked if any false information is supplied toward securing the permit/any unauthorized changes are made to the site/any unauthorized changes are made in the installation of the system. Improvement Permit with plat valid without expiration. Improvement Permit with site plan valid for sixty months. Authorization to Construct is valid for a period equal to that of Improvement Permit – not to exceed sixty months.

Signed: Margaret Young date 5/28/02 Installed by: Dobson Const. R.S.

Improvement Permit by: C. [illegible] RS date 5/23/02 Operation Permit by: Marion H. Dobson date 5/6/03

Authorization to Construct by: C. [illegible] RS date 5/23/02 Existing System Inspection by: date

HEALTH DEPT. COPY: WHITE OWNER COPY (FINAL): YELLOW OWNER COPY (INITIAL): PINK