IREDELL COUNTY HEALTH DEPARTMENT

STATESVILLE 704-878-5305 — MOORESVILLE 704-664-5281

IMPROVEMENT PERMIT / AUTHORIZATION TO CONSTRUCT / OPERATION PERMIT / EXISTING SYSTEM INSPECTION

PERMIT# 094959 PIN# 4625941684 pt 4625-62-3477 DATE 8-20-04

OWNER OR CONTRACTOR Dienst Custom Homes PHONE: Business 892-8426 Home

ADDRESS 9606-A Caldwell Commons Circle

LOCATION Brawley School Rd TR Attleboro TL Rehoboth Ln 2nd on left #119

SUBDIVISION The Point BLOCK / SECTION 7 LOT 737 LOT AREA 41,950 SITE CLASS. PS DESIGN FLOW 480gpd L.T.A.R. .3

Septic Tank: 1000+ Gallons; STB 338 Date 12-13-04
Pump Tank: 1000 Gallons; PT 283 Date 12-20-04
Pump Make: Gould's Model WE0312M Serial No.
Nitrification Field: No Fields 1 Square Feet Linear Feet 270'
No Lines 3@90' Trench Width 24"-36" Max Trench Bottom Depth 36" Gravel Depth NA

☒ New System ☐ Repair System Type: I, II, III, (IV) V, VI
System Description: Pump-LP-Panel Blk (Offsite
Repair System Description: Pump-LP-Panel Blk (On Site
Maintenance Agreement Required: ☒ Yes ☐ No & OFFSite


☒ House/Mod. Home No. Bedrooms 4
☐ Mobile Home No. Bathrooms 4
☐ Business No. Employees
☐ Other
☐ Slab ☐ Crawl Space ☒ Basement w/plumbing ☐ Basement wo/plumbing

Water Supply: ☐ Individual ☒ Public ☒ Community

Comments:/Conditions: Note: Septic Easement area located across the street from house.


Scale 1:50

INITIAL SITE SKETCH

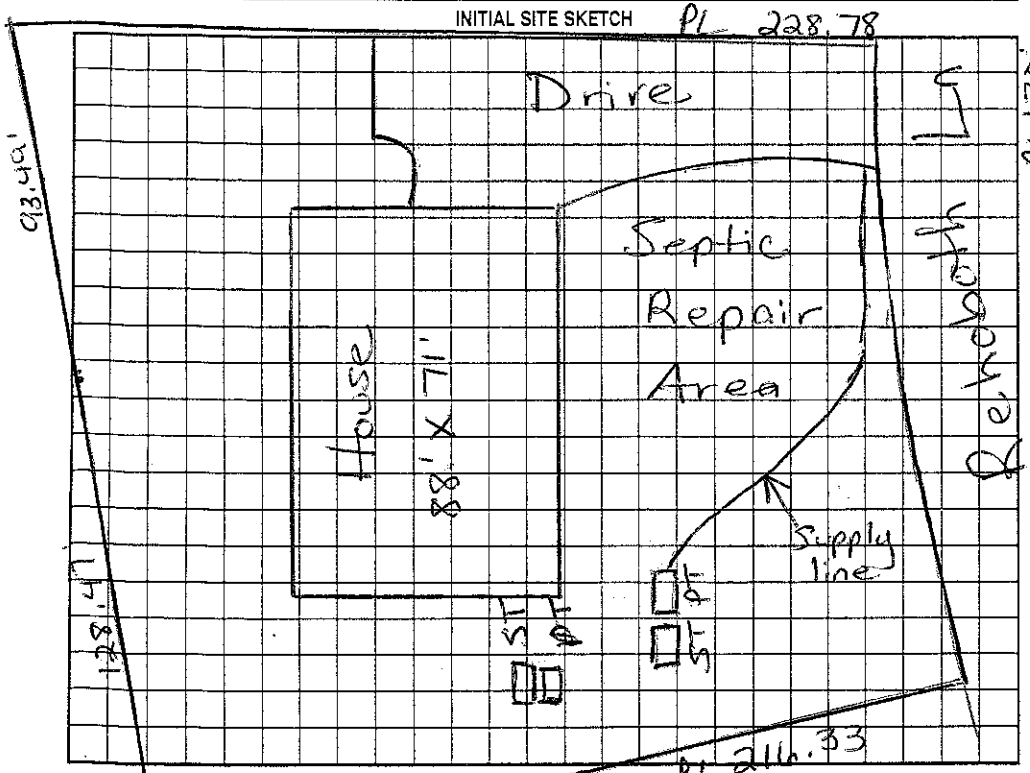

Comments:/Conditions: Lines Checked 1/18/05
Installed as drawn
Tanks checked 1/25/05 MD
Checked pres 2/2/05

AS BUILT SKETCH

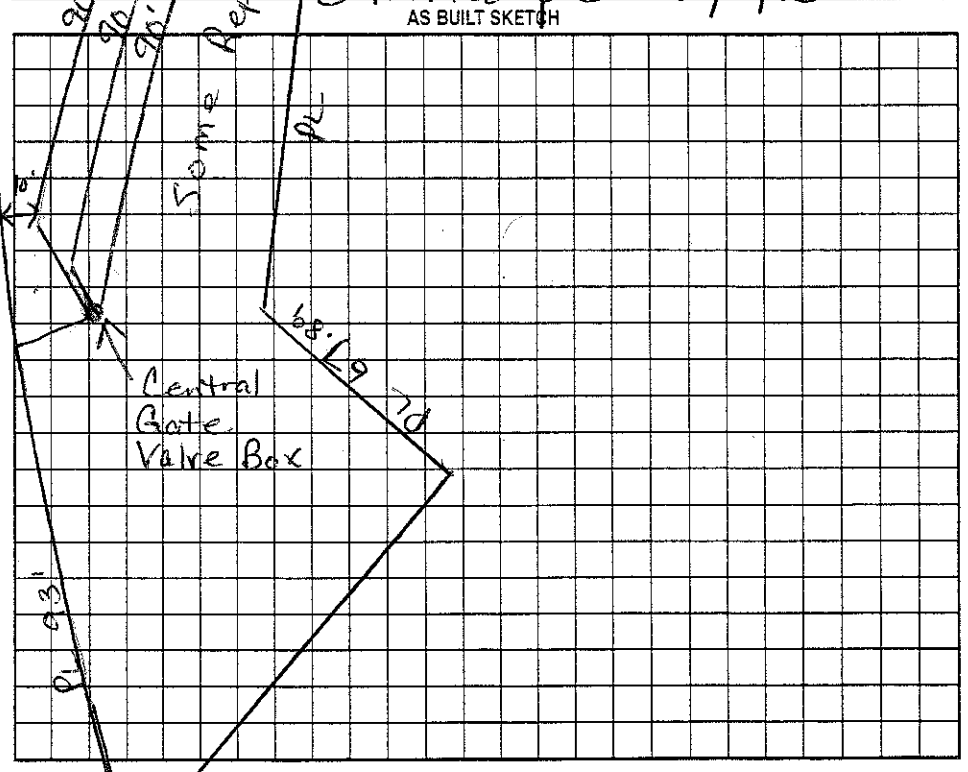

Permit can be suspended or revoked if any false information is supplied toward securing the permit/any unauthorized changes are made to the site/any unauthorized changes are made in the installation of the system. Improvement Permit with plat valid without expiration. Improvement Permit with site plan valid for sixty months. Authorization to Construct is valid for a period equal to that of Improvement Permit – not to exceed sixty months.

Signed: date 8/30/04 Installed by: RS

Improvement Permit by: Maria H Dotson RS date 8/20/04 Operation Permit by: Maria H Dotson RS date 2/3/05

Authorization to Construct by: Maria H Dotson RS date 8/20/04 Existing System Inspection by: date

HEALTH DEPT. COPY: WHITE OWNER COPY (FINAL): YELLOW OWNER COPY (INITIAL): PINK