IREDELL COUNTY HEALTH DEPARTMENT

STATESVILLE 704-878-5305 MOORESVILLE 704-664-5281

IMPROVEMENT PERMIT / AUTHORIZATION TO CONSTRUCT / OPERATION PERMIT / EXISTING SYSTEM INSPECTION

PERMIT# 94924 PIN# ~~4625944684~~ 4625-62-7969 DATE 7/31/01

OWNER OR CONTRACTOR BROOK SHIRE CONST PHONE: Business 895-8670 Home

ADDRESS 19900 WEST CATAWBA CORNELIUS NC 28231

LOCATION BRAWLEY SCHOOL RD - TR ATTLEBORO - ON RT

SUBDIVISION POINT BLOCK / SECTION 5 LOT 207 LOT AREA .36 170 M² SITE CLASS. PS DESIGN FLOW 480GPD L.T.A.R. .36 PD/FT²

Septic Tank: ~~1000~~ 1500 Gallons; STB 334 Date 10/18/02

Pump Tank: 1000 Gallons; PT 27 Date 9/21/02

Pump Make: GOULDS Model WE0712HA Serial No. 503806485

Nitrification Field: No Fields 1 Square Feet 900 Linear Feet 300

No Lines 3@100' Trench Width 24-36" Max Trench Bottom Depth 36" Gravel Depth N/A

☑ New System ☐ Repair System Type: I, II, III, IV, V, VI

System Description: LP PANEL

Repair System Description: SAME

Maintenance Agreement Required: ☑ Yes ☐ No

☑ House/Mod. Home No. Bedrooms 4

☐ Mobile Home No. Bathrooms 4

☐ Business No. Employees

☐ Other


☐ Slab ☑ Crawl Space ☑ Basement w/plumbing ☐ Basement wo/plumbing

Water Supply: ☐ Individual ☐ ~~Public~~ ☐ Community


Comments:/Conditions:

Comments:/Conditions:

INITIAL SITE SKETCH 1" = 50'

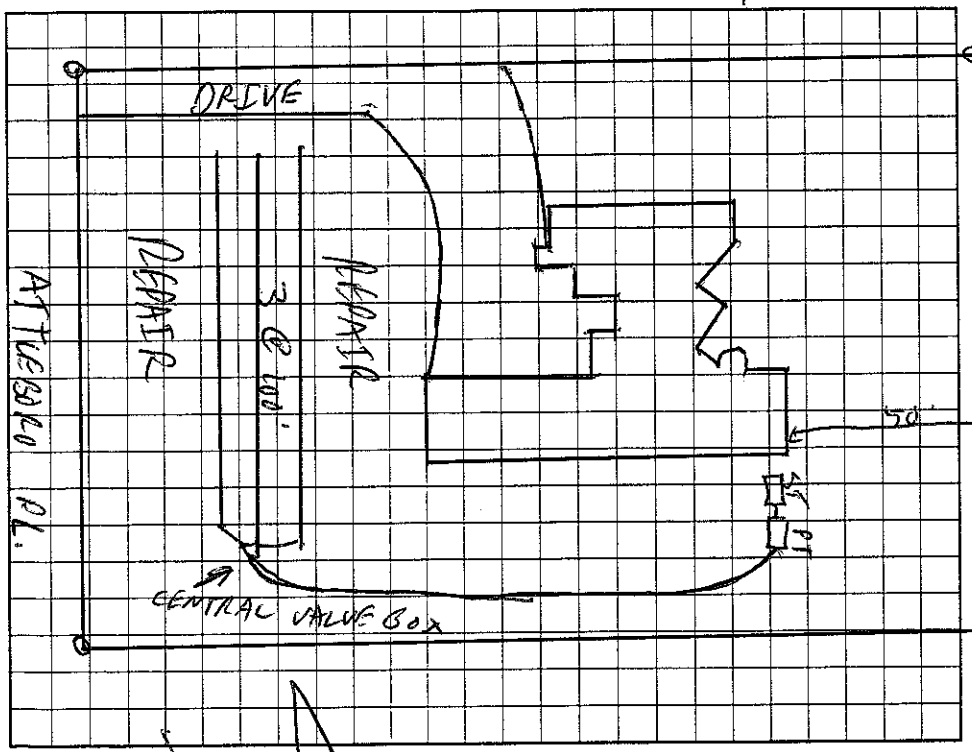

AS BUILT SKETCH

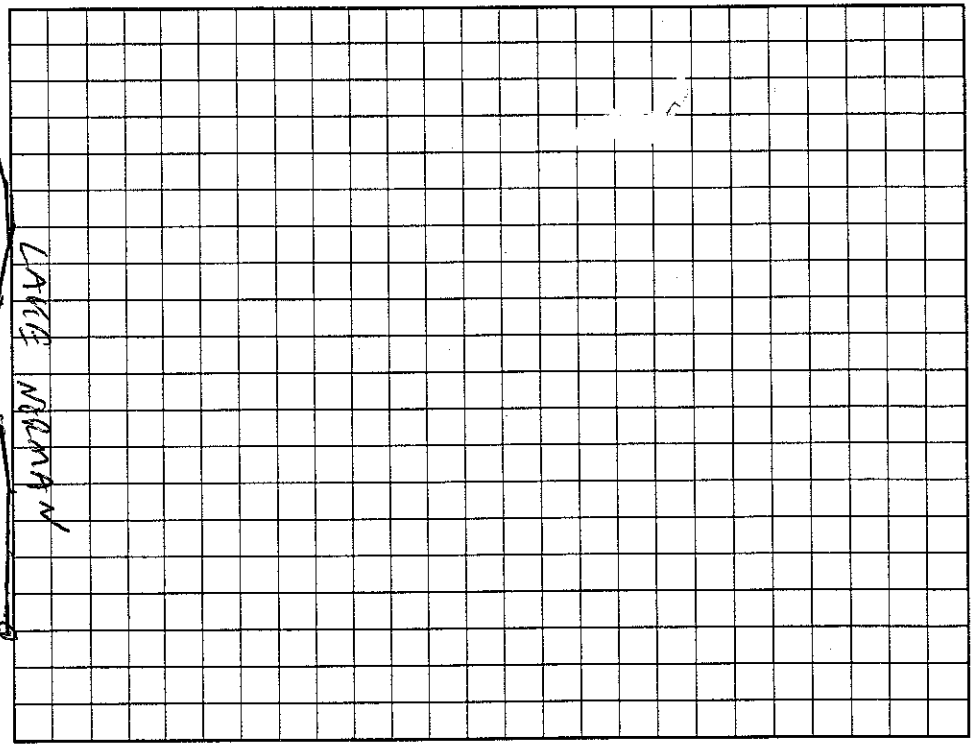

Permit can be suspended or revoked if any false information is supplied toward securing the permit/any unauthorized changes are made to the site/any unauthorized changes are made in the installation of the system. Improvement Permit with plat valid without expiration. Improvement Permit with site plan valid for sixty months. Authorization to Construct is valid for a period equal to that of Improvement Permit – not to exceed sixty months.

Signed: _____ date 8/3/01 Installed by: Hallman Const

Improvement Permit by: _____ RS date 7/31/01 Operation Permit by: _____ RS date 1/15/03

Authorization to Construct by: _____ RS date 7/31/01 Existing System Inspection by: _____ date _____

HEALTH DEPT. COPY: WHITE OWNER COPY (FINAL): YELLOW OWNER COPY (INITIAL): PINK