IREDELL COUNTY HEALTH DEPARTMENT

STATESVILLE 704-878-5305 500.00 Paid MOORESVILLE 704-664-5281

IMPROVEMENT PERMIT / AUTHORIZATION TO CONSTRUCT / OPERATION PERMIT / EXISTING SYSTEM INSPECTION

PERMIT# 094929 PIN# 4625 94 1684 (Lot) 4625-63-1087 DATE Sept. 26, 01

OWNER OR CONTRACTOR Crescent Resources Inc / Brookshire Construction PHONE: Business 895-5620 Home

ADDRESS P.O. Box 1003, Charlotte NC 19900 W. Catawba Cornelius, NC 28031

LOCATION Brawley Sch Rd TR Attleboro 8th on Right

SUBDIVISION The Point BLOCK SECTION 7 LOT 711 LOT AREA 43175 ft² + SFE 711A SITE CLASS. PS DESIGN FLOW 480gpd L.T.A.R. 3, Initial 1.2 Repair 711A

Septic Tank: 1500 Gallons; STB 338 Date 5/21/02

Pump Tank: 1000 Gallons; PT 27 Date 5/21/02

Pump Make: Gould Model NEO 712HH Serial No. E025154

Nitrification Field: No Fields 1 Square Feet 600/900 Linear Feet 300

No Lines 5 Trench Width 24" min 36" Max Trench Bottom Depth 36" Gravel Depth NA

☑ New System ☐ Repair System Type: I, II, III, IV, V, VI

System Description: 2 PPPBPS

Repair System Description: 2 PPPBPS on 711A (720)

Maintenance Agreement Required: ☐ Yes ☐ No

☑ House/Mod. Home No. Bedrooms 4

☐ Mobile Home No. Bathrooms 4

☐ Business No. Employees

☐ Other

☐ Slab ☐ Crawl Space ☐ Basement w/plumbing ☐ Basement wo/plumbing


Water Supply: ☐ Individual ☐ ~~Public~~ ☐ ~~Community~~

Comments:/Conditions: OR 36" max 9'oc


This permit replaces earlier permit issued 5-14-01.

Comments:/Conditions:

INITIAL SITE SKETCH 1"=50'

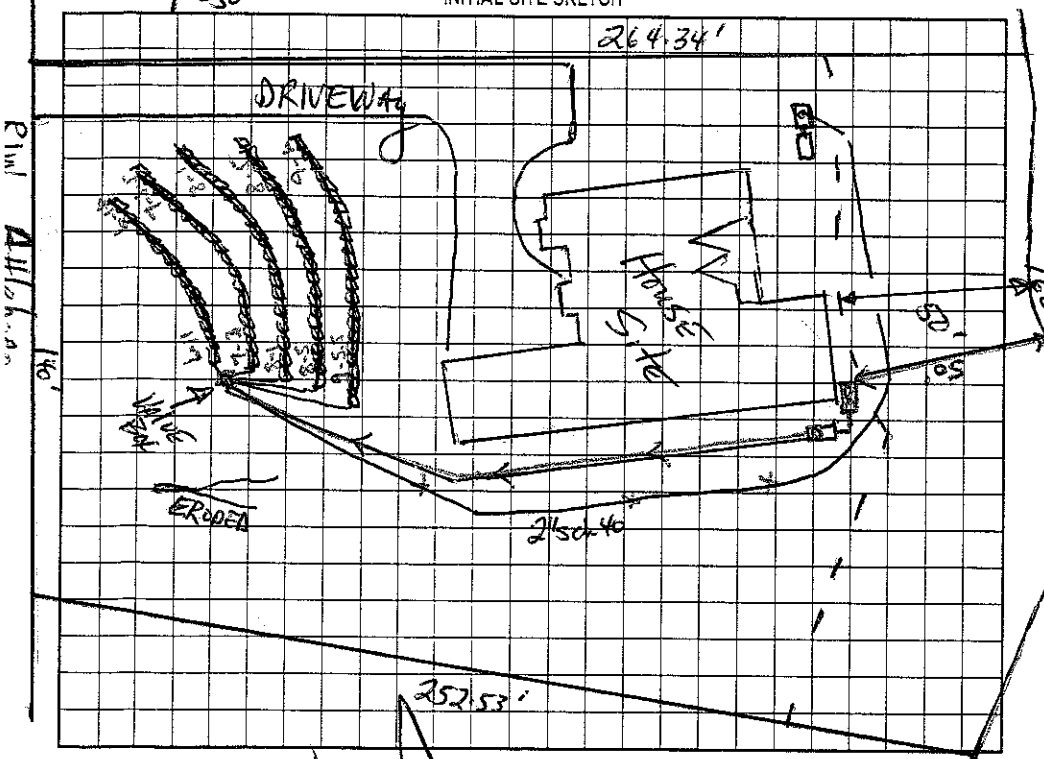

AS BUILT SKETCH

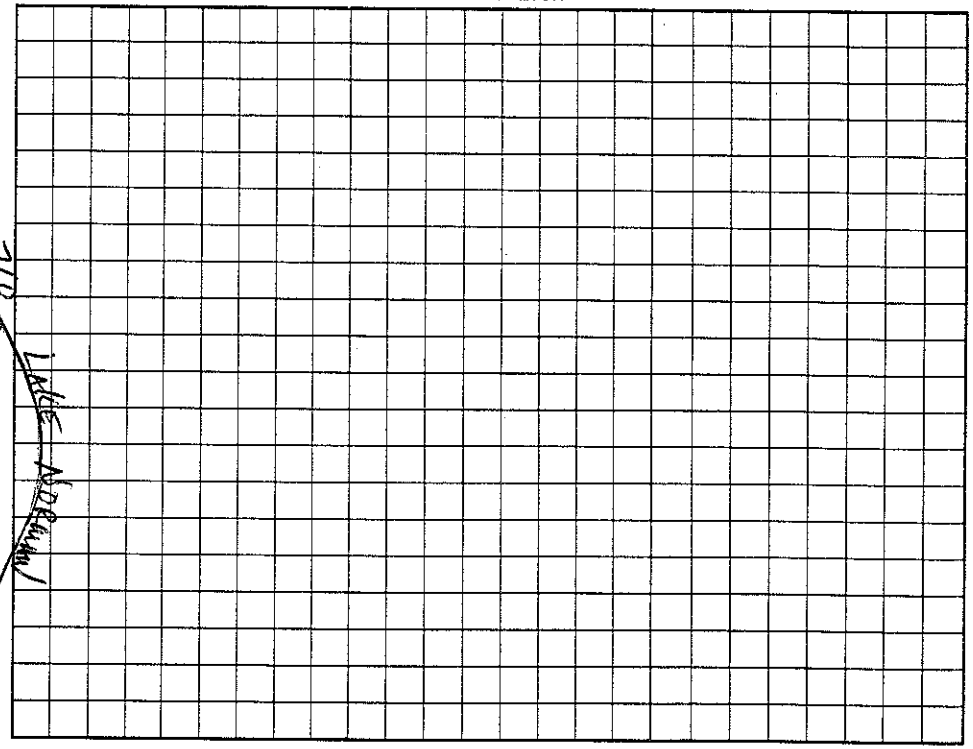

Permit can be suspended or revoked if any false information is supplied toward securing the permit/any unauthorized changes are made to the site/any unauthorized changes are made in the installation of the system. Improvement Permit with plat valid without expiration. Improvement Permit with site plan valid for sixty months. Authorization to Construct is valid for a period equal to that of Improvement Permit – not to exceed sixty months.

Signed: date 9/27/01 Installed by: Hallmon Const.

Improvement Permit by: Laura R Johnson, RS date 9-26-01 Operation Permit by: Wesley Sparks RS date 8/1/02

Authorization to Construct by: Laura R Johnson, RS date 9-26-01 Existing System Inspection by: date

HEALTH DEPT. COPY: WHITE OWNER COPY (FINAL): YELLOW OWNER COPY (INITIAL): PINK