$525

IREDELL COUNTY HEALTH DEPARTMENT

STATESVILLE 704-878-5305 MOORESVILLE 704-664-5281

IMPROVEMENT PERMIT / AUTHORIZATION TO CONSTRUCT / OPERATION PERMIT / EXISTING SYSTEM INSPECTION

PERMIT# 094929 PIN# 4625 94 1684 (pt.) DATE May 14, 01

OWNER OR CONTRACTOR Crescent Resources Llc. PHONE: Business _____ Home _____

ADDRESS P.O. Box 1003, Charlotte 28201-1003

LOCATION Brawley Sch Rd. TR Attleboro 8th on Right

SUBDIVISION The Point BLOCK / SECTION 7 LOT 711 LOT AREA 43175 ft² SITE CLASS. PS DESIGN FLOW 480 gpd L.T.A.R. .825-03

Septic Tank: 1000+ Gallons; STB _____ Date _____

Pump Tank: 1000 Gallons; PT _____ Date _____

Pump Make: _____ Model _____ Serial No. _____

Nitrification Field: No Fields 1 Square Feet 600/900 Linear Feet 300

No Lines 3 Trench Width 24" min 60" Max Trench Bottom Depth 36" Gravel Depth N/A

☑ New System ☐ Repair System Type: I. II. III. IV. V. VI

System Description: LPP BPS

Repair System Description: SAME

Maintenance Agreement Required: ☑ Yes ☐ No

☑ House/Mod. Home No. Bedrooms 4

☐ Mobile Home No. Bathrooms 4

☐ Business No. Employees _____

☐ Other _____


☐ Slab ☑ Crawl Space ☑ Basement w/plumbing ☐ Basement wo/plumbing

Water Supply: ☐ Individual ☑ Public ☑ Community


Comments:/Conditions: OR 36" 9'oc max

Comments:/Conditions: (partial)

INITIAL SITE SKETCH

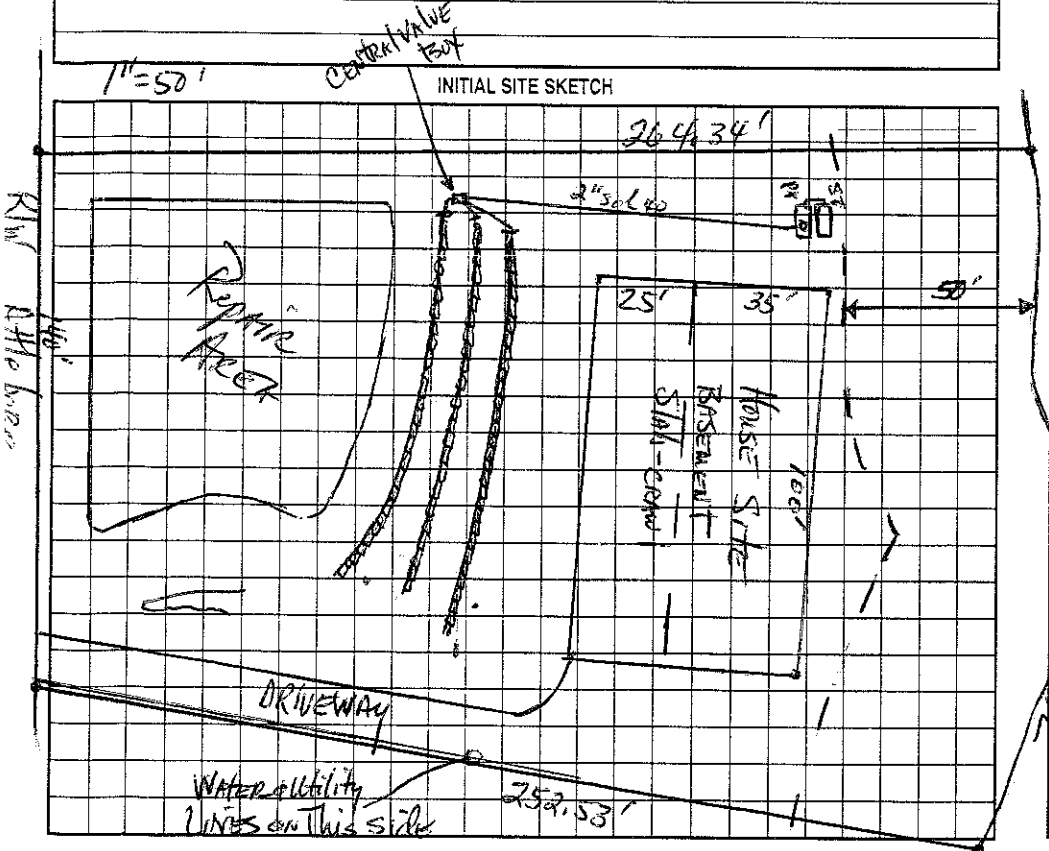

AS BUILT SKETCH

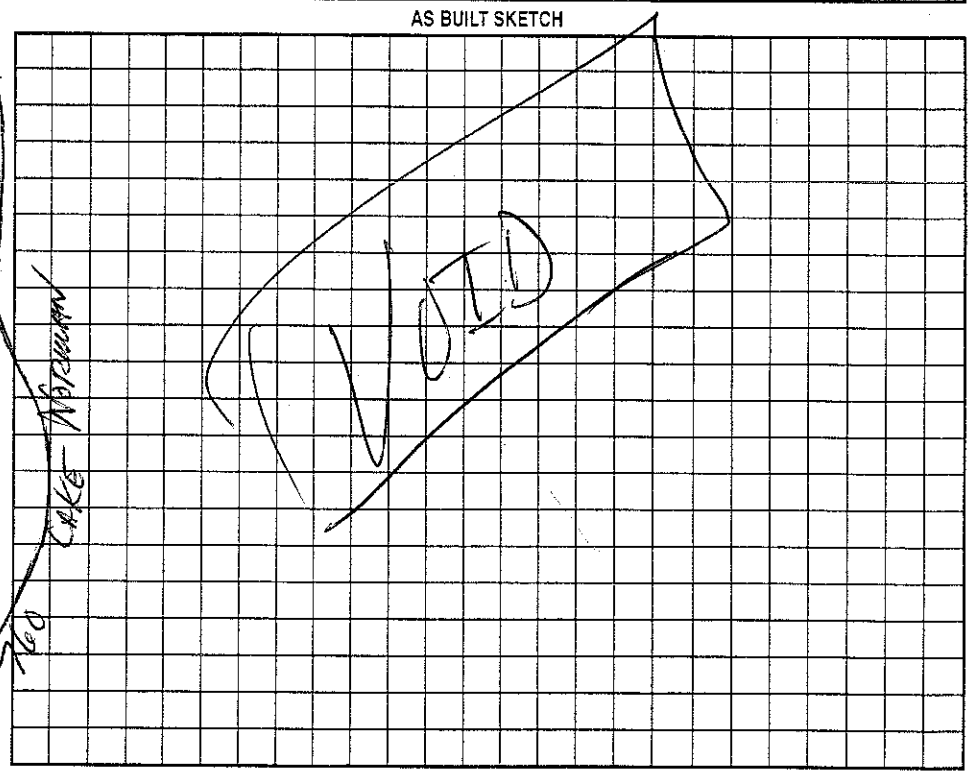

Permit can be ~~suspended~~ or revoked if any false information is supplied toward securing the permit/any unauthorized changes are made to the site/any unauthorized changes are made in the installation of the system. Improvement Permit with plat valid without expiration. Improvement Permit with site plan valid for sixty months. Authorization to Construct is valid for a period equal to that of Improvement Permit – not to exceed sixty months.

Signed: _____ date 6-15-01 Installed by: _____

Improvement Permit by: _____ date 5-14-01 Operation Permit by: _____ date _____

Authorization to Construct by: _____ date _____ Existing System Inspection by: _____ date _____

HEALTH DEPT. COPY: WHITE OWNER COPY (FINAL): YELLOW OWNER COPY (INITIAL): PINK