IREDELL COUNTY HEALTH DEPARTMENT

STATESVILLE 704-878-5305 MOORESVILLE 704-664-5281

IMPROVEMENT PERMIT / AUTHORIZATION TO CONSTRUCT / OPERATION PERMIT / EXISTING SYSTEM INSPECT

PERMIT# 90747 PIN# ~~4625944854~~ 4625-63-2772 DATE 10/17/00

OWNER OR CONTRACTOR CRESCENT RESOURCES / Helms Const. PHONE: Business 663 6905 Home

ADDRESS PO BOX 1003 CHARLOTTE NC 28201

LOCATION BRAWLEY SCHOOL - TR STONEWALL BEACH - TR STANDISH-ON RT

SUBDIVISION POINT BLOCK / SECTION 6 LOT 6/9 LOT AREA 34555 ft² SITE CLASS. PS DESIGN FLOW 480GPD L.T.A.R. .3000 /FT

Septic Tank: 1000+ Gallons; STB 338 Date 3-16-02

Pump Tank: 1000+ Gallons; PT 283 Date 3-17-02

Pump Make: Myers Model ME33F Serial No.

Nitrification Field: No Fields 1 Square Feet 810 Linear Feet 270

No Lines 3@90' Trench Width 36" Max Trench Bottom Depth 36" Gravel Depth N/A

☑ New System ☐ Repair System Type: I, II, III, IV, V, VI

System Description: PUMP UP PANEL

Repair System Description: SAME

Maintenance Agreement Required: ☑ Yes ☐ No

☑ House/Mod. Home No. Bedrooms 4

☐ Mobile Home No. Bathrooms 4

☐ Business No. Employees

☐ Other

☐ Slab ☑ Crawl Space ☑ Basement w/plumbing ☐ Basement wo/plumbing

Water Supply: ☐ Individual ☐ Public ☑ Community

Comments:/Conditions: REMOVE TERRACES AND BERMS.


DO NOT GO BEYOND SETBACK LINE WITH SYSTEM OR REPAIR

Comments:/Conditions: ~~PARTIAL BASEMENT ONLY~~

House plans and Site reviewed 9/11/01


full Basement OK - No significant changes needed to be made to permit - GM

INITIAL SITE SKETCH 1" = 50'

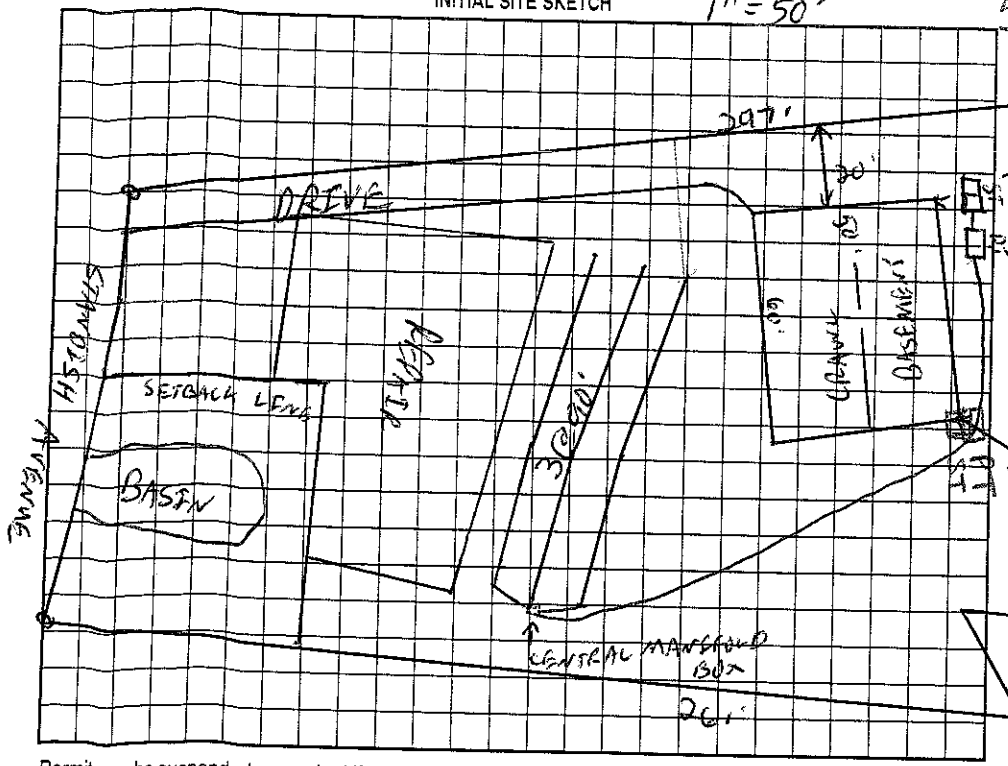

5/52 hole drilled

AS BUILT SKETCH

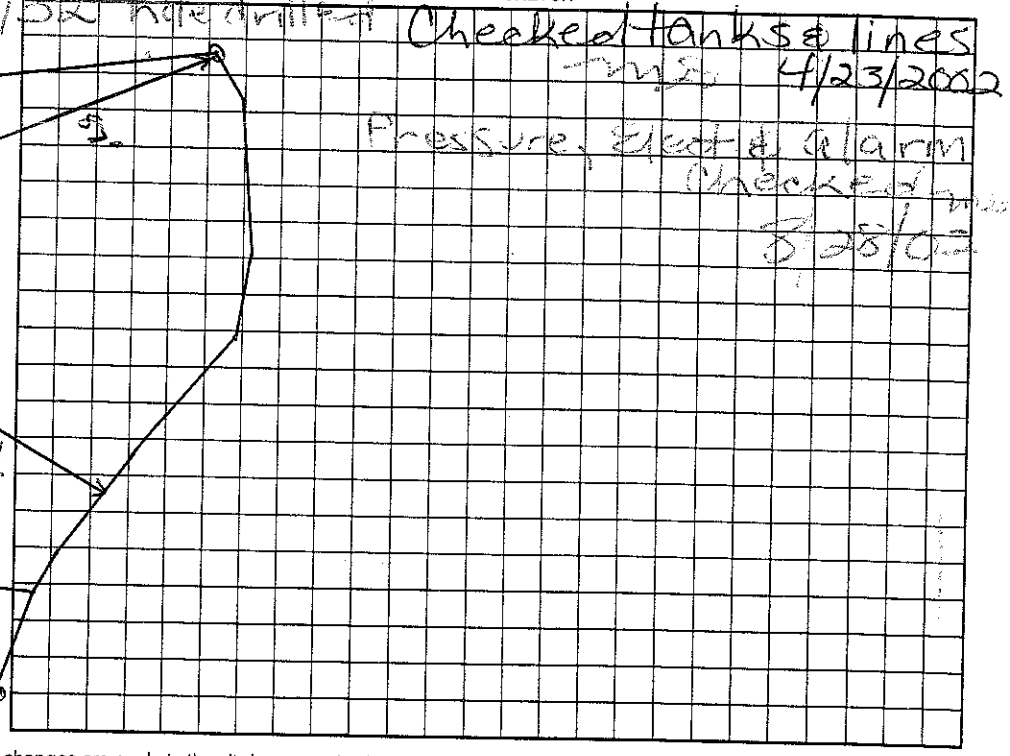

Checked tanks & lines - mh 4/23/2002

Pressure, float & alarm Checked - mh 5/25/02

Permit can be suspended or revoked if any false information is supplied toward securing the permit/any unauthorized changes are made to the site/any unauthorized changes are made in the installation of the system. Improvement Permit with plat valid without expiration. Improvement Permit with site plan valid for sixty months. Authorization to Construct is valid for a period equal to that of Improvement Permit – not to exceed sixty months.

Signed: [signature] Agent date 10/25/00

Improvement Permit by: [signature] REHS date 10/17/00

Authorization to Construct by: [signature] RSI date 9/11/01

Installed by: R & H Inc

Operation Permit by: [signature] REHS date 8/28/2002

Existing System Inspection by: date

HEALTH DEPT. COPY: WHITE OWNER COPY (FINAL): YELLOW OWNER COPY (INITIAL): PINK