$ 325 3:00

IREDELL COUNTY HEALTH DEPARTMENT

STATESVILLE 704-878-5305 MOORESVILLE 704-664-5281

IMPROVEMENT PERMIT / AUTHORIZATION TO CONSTRUCT / OPERATION PERMIT / EXISTING SYSTEM INSPECTION

PERMIT# 094928 PIN# 4625 94 1684 (pt.) 4625-63-3047 DATE May 10, 01

OWNER OR CONTRACTOR Crescent Resources-Inc. - If Diff'nt Custom Homes PHONE: Business Home

ADDRESS P.O. Box 1003 Charlotte NC 28201

LOCATION Brawley Sch Rd TR Athlebora Pt. on Right

SUBDIVISION The Point BLOCK / SECTION 7 LOT 710 LOT AREA 36,658 ft² SITE CLASS. PS DESIGN FLOW 480gpd L.T.A.R. .03

Septic Tank: ~~1000+~~ 1500 Gallons; STB 338 Date 1-8-02

Pump Tank: 1000 Gallons; PT 27 Date 4-6-02

Pump Make: Me 50 Model Serial No.

Nitrification Field: No. Fields 1 Square Feet 600/900 Linear Feet 300

No. Lines 3@100' Trench Width 24" min 18" Max Trench Bottom Depth 36" Gravel Depth NA

OR 36" min 9" cc

☑ New System ☐ Repair System Type: I, II, III, IV, V, VI

System Description: LP PPBPS

Repair System Description: SAME

Maintenance Agreement Required: ☑ Yes ☐ No

☑ House/Mod. Home ☐ Mobile Home ☐ Business ☐ Other

No. Bedrooms 4 No. Bathrooms 4 No. Employees

☐ Slab ☑ Crawl Space ☑ Basement w/plumbing ☐ Basement wo/plumbing

Water Supply: ☐ Individual ☑ Public ☐ Community

Comments:/Conditions:


Comments:/Conditions: (INITIAL)

Installed filter

Checked tanks & lines 5/7/2002

Press, Elect & alarm checked 7/17/02

INITIAL SITE SKETCH

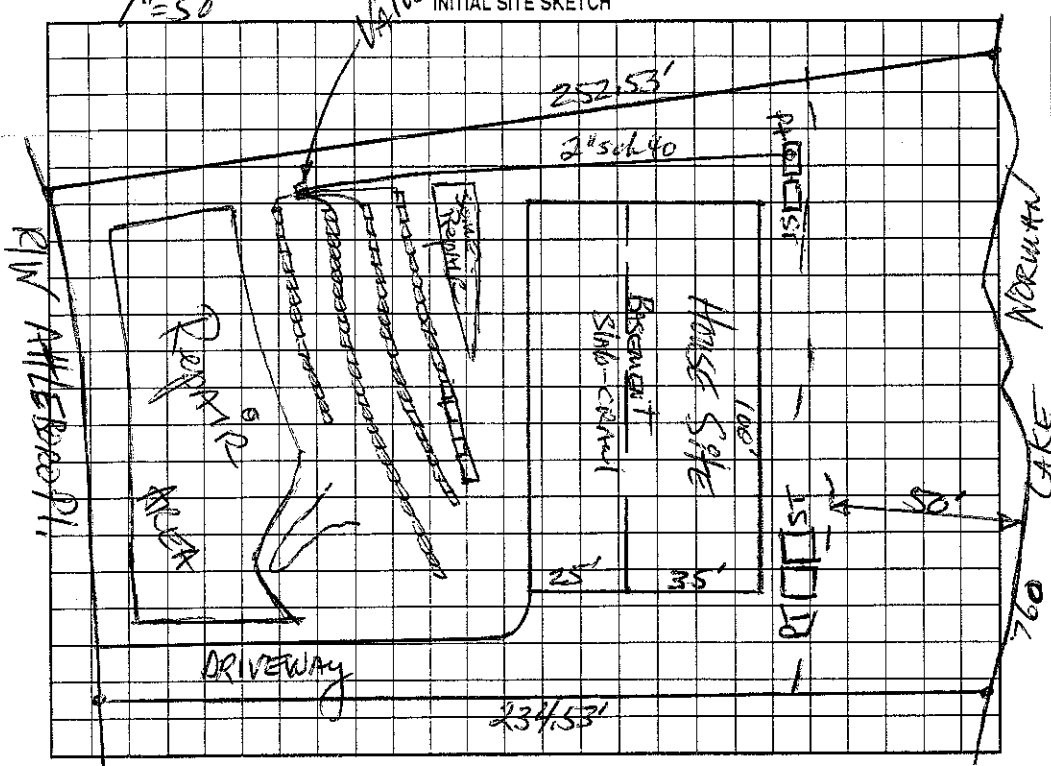

AS BUILT SKETCH

Installed 3 lines @ 100' ea.

Permit can be suspended or revoked if any false information is supplied toward securing the permit/any unauthorized changes are made to the site/any unauthorized changes are made in the installation of the system. Improvement Permit with plat valid without expiration. Improvement Permit with site plan valid for sixty months. Authorization to Construct is valid for a period equal to that of Improvement Permit – not to exceed sixty months.

Signed: [signature] date 6-15-01 Installed by: R & H Inc.

Improvement Permit by: [signature] RS date 5-10-01 Operation Permit by: Maria H Dotson RS date 7/17/2002

Authorization to Construct by: [signature] RS date 11-27-01 Existing System Inspection by: date

HEALTH DEPT. COPY: WHITE OWNER COPY (FINAL): YELLOW OWNER COPY (INITIAL): PINK