IREDELL COUNTY HEALTH DEPARTMENT

TATESVILLE 704-878-5305 MOORESVILLE 70[illegible]

IMPROVEMENT PERMIT / AUTHORIZATION TO CONSTRUCT / OPERATION PERMIT / EXISTING SYSTEM INSPECTION

PERMIT# 094927/11577 PIN# 4625-94-1684-pt. 4625-63-4084 DATE 9/9/03

OWNER OR CONTRACTOR Arcadia Homes PHONE: Business 704 201-7181 Home

ADDRESS 315 Main St. Pineville NC 28134

LOCATION BSR, TR Attleboro on Rt #160

SUBDIVISION Point BLOCK / SECTION 7 LOT 709 LOT AREA 32,931ft² SITE CLASS. PS DESIGN FLOW 600 L.T.A.R. 0.3

Septic Tank: 1500 Gallons; STB 338 Date 7-5-04
Pump Tank: 1500 Gallons; PT 421 Date 6-21-04
Pump Make: Myers Model ME 50 Serial No.
Nitrification Field: No Fields 1 Square Feet 990 Linear Feet 330
No Lines 3@110' Trench Width 36" Max Trench Bottom Depth 56" Gravel Depth —

☒ New System ☐ Repair System Type: I, II, III, (IV), V, VI
System Description: LP Panel Block
Repair System Description: Same
Maintenance Agreement Required: ☒ Yes ☐ No


☒ House/Mod. Home No. Bedrooms 5
☐ Mobile Home No. Bathrooms 5
☐ Business No. Employees
☐ Other
☐ Slab ☐ Crawl Space ☒ Basement w/plumbing ☐ Basement wo/plumbing

Water Supply:
☐ Individual
☐ Public
☒ Community


Comments/Conditions:

Comments/Conditions: 8/10/04 Tanks checked & waterline relocation

INITIAL SITE SKETCH

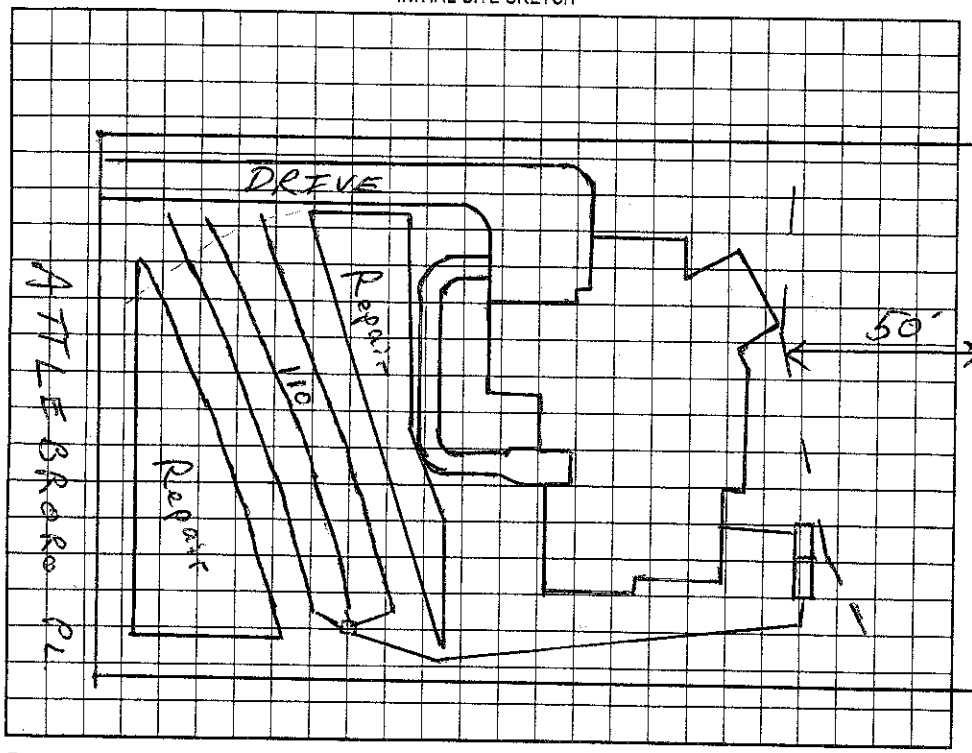

AS BUILT SKETCH

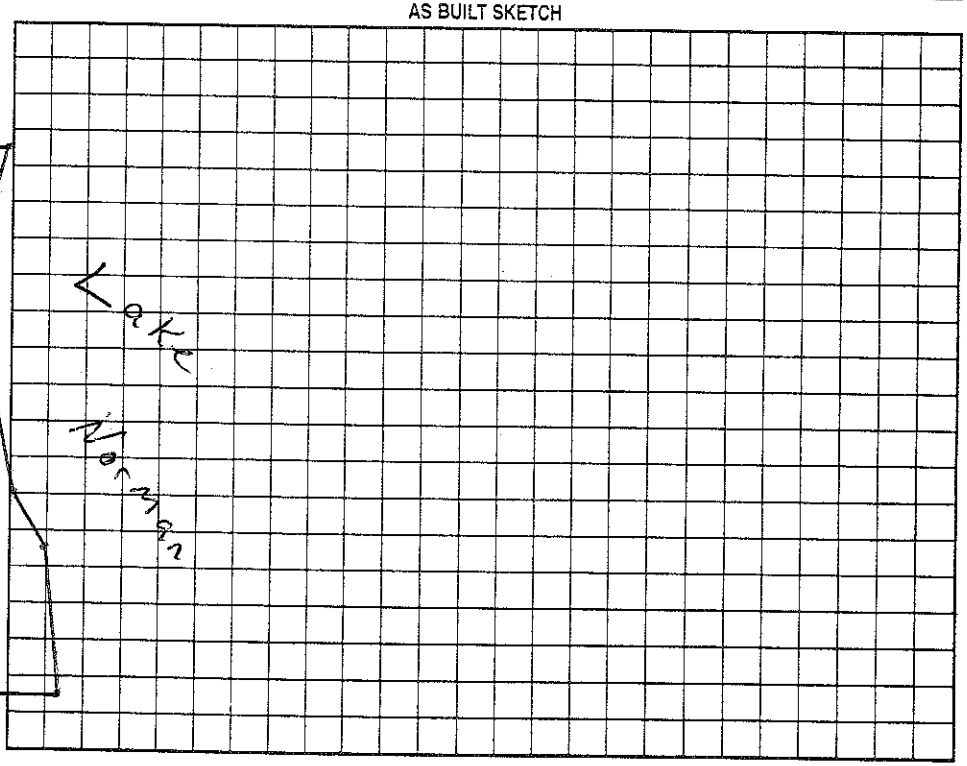

Permit can be suspended or revoked if any false information is supplied toward securing the permit/any unauthorized changes are made to the site/any unauthorized changes are made in the installation of the system. Improvement Permit with plat valid without expiration. Improvement Permit with site plan valid for sixty months. Authorization to Construct is valid for a period equal to that of Improvement Permit – not to exceed sixty months.

Signed: BKD date 9/9/03 Installed by: R+H RS

Improvement Permit by: RS date 9/9/03 Operation Permit by: Marvin H. Dotson date 9/30/04

Authorization to Construct by: RS date 9/9/03 Existing System Inspection by: date

HEALTH DEPT. COPY: WHITE OWNER COPY (FINAL): YELLOW OWNER COPY (INITIAL): PINK