IREDELL COUNTY HEALTH DEPARTMENT

Statesville Office (704) 878-5305 Mooresville Office (704) 660-3625 PERMIT # 210921

IMPROVEMENT PERMIT / AUTHORIZATION TO CONSTRUCT / OPERATION PERMIT / EXISTING SYSTEM

PIN # 4625634084

APPLICANT: BILL STOCK APPLICANT ADDRESS: 160 ATTLEBORO PLACE MOORESVILLE, NC. 28117

SITE ADDRESS: SAME PHONE: ALT. PHONE: 708-308-8073

SITE DIRECTIONS: BRAWLEY SCH JR ATTLEBORO, # 160 ON (R)

SUBDIVISION: KL POINT SECTION: 7 LOT # 709 LOT AREA: .75 DESIGN FLOW: L.T.A.R.:


Septic Tank	1500	(gal)	STB	Date	☐ New System	☐ Repair	☐ Expansion	System Type: I II III (IV) V VI	☑ Residence	No. Bedrooms	Water Supply
Pump Tank	1500	(gal)	PT	Date	System Description:	EXISTING-ARES. PANEL			☐ Business	No. Persons	☐ Private
Pump Make		Model		Serial #	Repair System Description:				☐ Other	No. Employees	☐ Public
# Nitrification Fields	1	# Lines	3	Linear Ft: 330	Maintenance Agreement Required:	☐ YES	☐ NO		☐ Slab	☐ Crawl Space	☑ Community
Trench Width		Max. Trench Bottom Depth		Gravel Depth		☐ GRAVITY	☑ PRESSURE		☐ Basement w/plumbing		☐ Basement w/o plumbing

Comments / Conditions:

EXISTING SYSTEM - SPA 24' FROM S/T

INITIAL SITE SKETCH

AS BUILT SKETCH

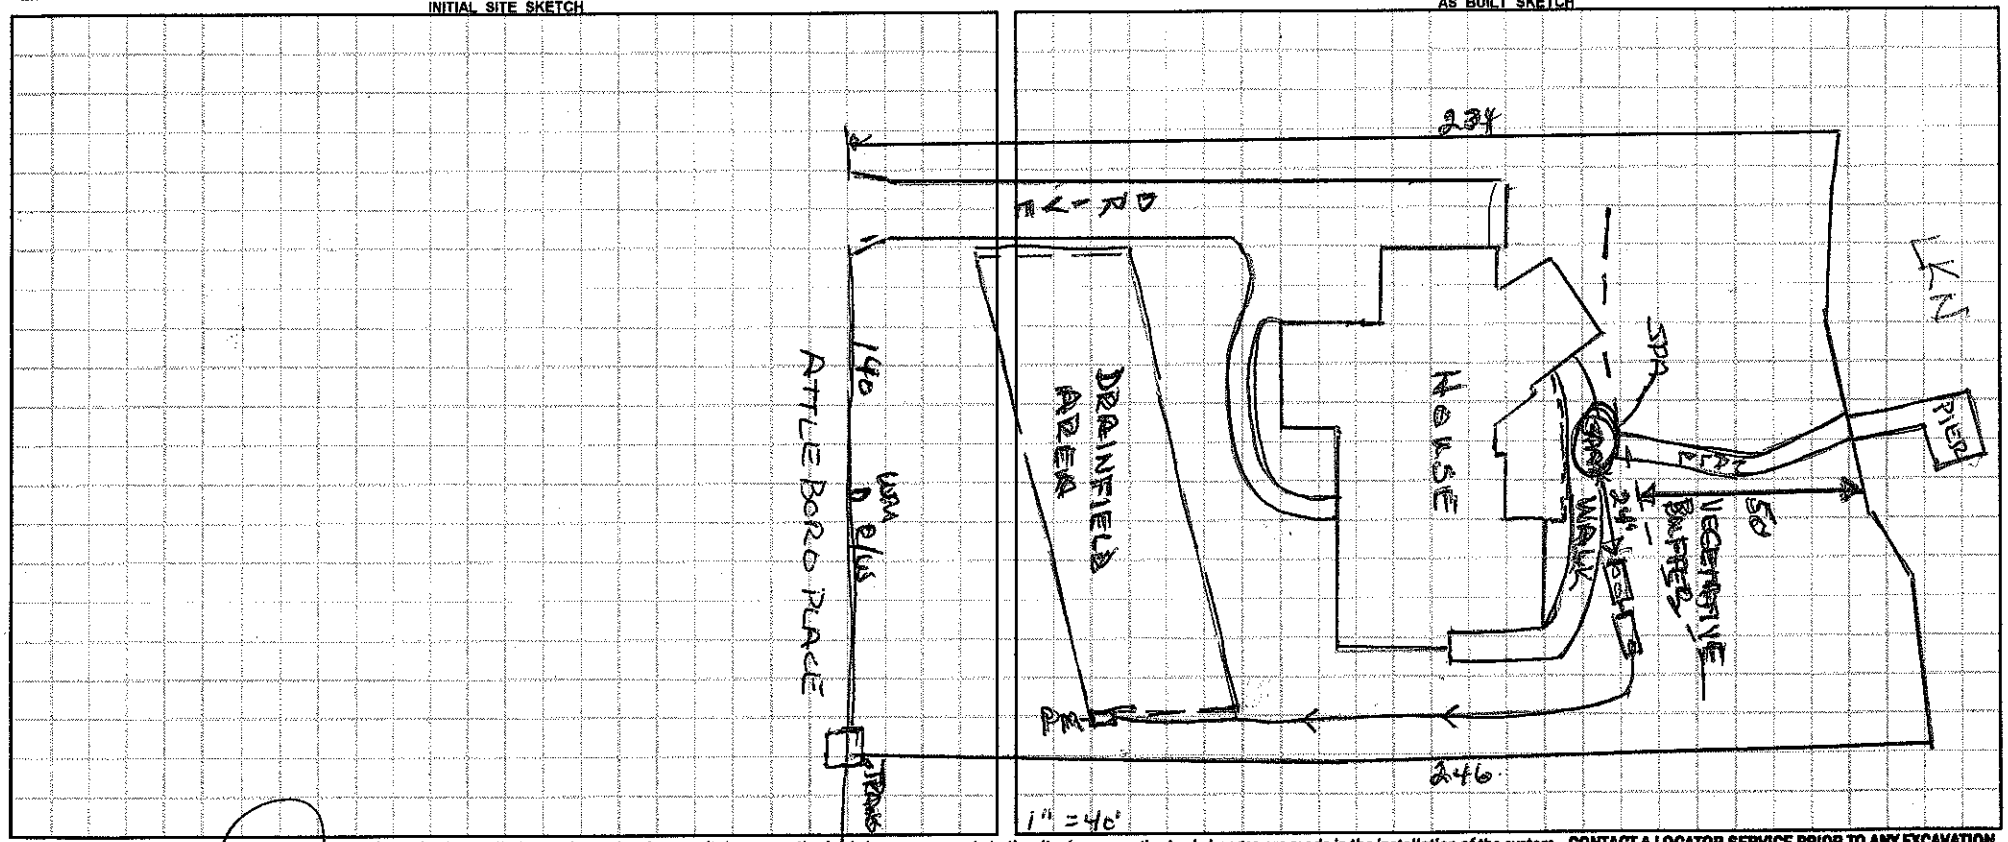

Permit can be suspended or revoked if any false information is supplied toward securing the permit / any unauthorized changes are made to the site / any unauthorized changes are made in the installation of the system. **CONTACT A LOCATOR SERVICE PRIOR TO ANY EXCAVATION**

☐ **IMPROVEMENT PERMIT** *with plat valid without expiration.* ☐ **IMPROVEMENT PERMIT** *with site plan valid for 60 mos.* ☐ **AUTHORIZATION TO CONSTRUCT** *valid for period equal to IMPROVEMENT PERMIT--not to exceed 60 mo.*

Owner / Applicant Signature: David Moore Date: 7/7/15 Installed by:

IMPROVEMENT PERMIT by: Date: OPERATION PERMIT by: Date:

AUTHORIZATION TO CONSTRUCT by: Date: Existing System Inspected by: Wesley Sparks Date: 6/16/2015

Health Dept. Copy - WHITE Applicant (Final Approval) - YELLOW Applicant (Conditional Approval) - PINK