IREDELL COUNTY HEALTH DEPARTMENT

Statesville Office (704) 878-5305 Mooresville Office (704) 660-3625 PERMIT # 179076

IMPROVEMENT PERMIT / AUTHORIZATION TO CONSTRUCT / OPERATION PERMIT / EXISTING SYSTEM

PIN # 4625635527

APPLICANT: Stonebridge Luxury Homes APPLICANT ADDRESS: P.O. Box 4297 Mooresville, NC 28117

SITE ADDRESS: 156 Standish Ln Mooresville, NC 28117 PHONE: 7046628625 ALT. PHONE: 400-1235 Ron

SITE DIRECTIONS: Brawley School Rd TR Stonewall Beach TR Standish on right

SUBDIVISION: Point on Norman SECTION: 6 LOT # 621 LOT AREA: .87Ac DESIGN FLOW: 480gpd L.T.A.R.: .3

Septic Tank	1000 (gal)	STB	338	Date		☒ New System ☐ Repair ☐ Expansion	System Type: I II III (IV) V VI	☒ Residence	No. Bedrooms 4
Pump Tank	1000 (gal)	PT	283	Date		System Description: LP- Panel Blocks		☐ Business	No. Persons 8
Pump Make	Orenco	Model	PF50511	Serial #		Repair System Description: Same		☐ Other	No. Employees
# Nitrification Fields	1	# Lines	3	Linear Ft:	270'	Maintenance Agreement Required: ☒ YES ☐ NO		☐ Slab	☐ Crawl Space
Trench Width	min 24"	Max. Trench Bottom Depth	36"	Gravel Depth	N/A	☐ GRAVITY ☒ PRESSURE		☒ Basement w/plumbing	☐ Basement w/o plumbing


Water Supply: ☐ Private ☐ Public ☒ Community

Comments / Conditions: * Refer to Crescent Communities On-Site Wastewater Installation Specification Tanks & lines Checked by BA


* Original Septic Evaluation & plan prepared by SAME (attached) Keep tanks 15ft (side slope) from house

PL 272'

INITIAL SITE SKETCH

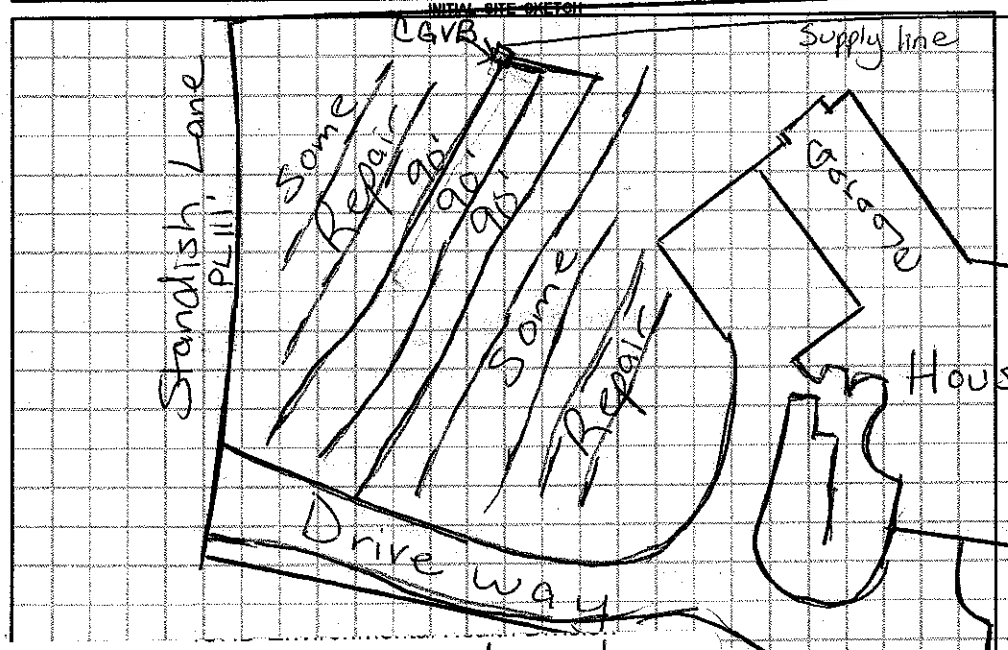

AS BUILT SKETCH

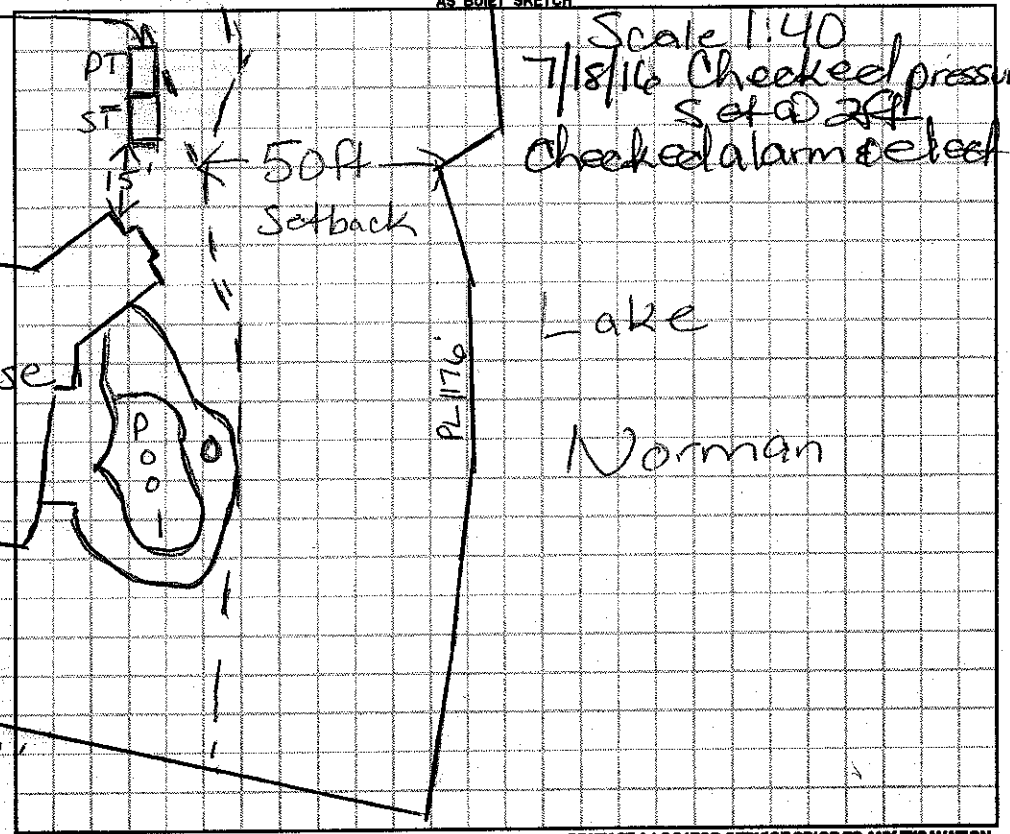

Scale 1:40
7/18/16 Checked pressure Set @ 28ft Checked alarm & float.

The proposed / existing Inground pool addition does not appear to impact the existing septic system.
**NOTE: Must keep pool at least 15ft from Septic Maria Dotson R.S.
Date: 12/2/14
ICHD-Environmental Health Division

206664

Permit can be suspended or revoked if any false information is supplied toward securing the permit / any unauthorized changes are made to the site / any unauthorized changes are made in the installation of the system. **CONTACT A LOCATOR SERVICE PRIOR TO ANY EXCAVATION**

☐ **IMPROVEMENT PERMIT** *with plat valid without expiration.* ☒ **IMPROVEMENT PERMIT** *with site plan valid for 60 mos.* ☒ **AUTHORIZATION TO CONSTRUCT** *valid for period equal to IMPROVEMENT PERMIT--not to exceed 60 mo.*

Owner / Applicant Signature: Allen Arrington Date: 12/2/14 Installed by: Steve Jordan

IMPROVEMENT PERMIT by: Maria Dotson RS Date: 12/2/14 OPERATION PERMIT by: Maria Dotson Date: 7/18/16

AUTHORIZATION TO CONSTRUCT by: Maria Dotson RS Date: 12/2/14 Existing System Inspected by: Date:

Health Dept. Copy - WHITE Applicant (Final Approval) - YELLOW Applicant (Conditional Approval) - PINK