IREDELL COUNTY HEALTH DEPARTMENT

STATESVILLE 704-878-5305 MOORESVILLE 704-664-5281

IMPROVEMENT PERMIT / AUTHORIZATION TO CONSTRUCT / OPERATION PERMIT / EXISTING SYSTEM INSPECTION

PERMIT# 90777 PIN# 4625 94 1684 PT 4625 63 5845 DATE 10/24/00

OWNER OR CONTRACTOR CRESCENT RESOURCES / Brook Shire PHONE: Business 662-6905 Home

ADDRESS PO Box 1003 CHARLOTTE NC 28201

LOCATION BRAWLEY SCHOOL - TR STONEWALL BEACH - TR STANDISH - ON LT

SUBDIVISION POINT BLOCK / SECTION 6 LOT 647 LOT AREA 36029 ft² SITE CLASS. RS DESIGN FLOW 400GPD L.T.A.R. .36 PD/FT²

Septic Tank: 1000 + Gallons: STB 338 Date 1-11-02

Pump Tank: 1000 + Gallons: PT 338-283 Date 1-11-02

Pump Make: Goulds Model WE0312M Serial No.

Nitrification Field: No Fields 1 Square Feet 1200 Linear Feet 400

No Lines 5@80' Trench Width 36" Max Trench Bottom Depth 36" Gravel Depth N/A

☑ New System ☐ Repair System Type: I, II, III, IV, V, VI

System Description: PUMP 25% REDUCTION

Repair System Description: PUMP UP PANEL

Maintenance Agreement Required: ☐ Yes ☑ No

☑ House/Mod. Home No. Bedrooms 4

☐ Mobile Home No. Bathrooms 4

☐ Business No. Employees

☐ Other

☐ Slab ☑ Crawl Space ☐ Basement w/plumbing ☐ Basement wo/plumbing


Water Supply: ☐ Individual ☐ Public ☑ ~~Community~~

Comments:/Conditions: REMOVE TERRACES AND BERMS

6/20/01 Reviewed plans that essentially comply with all this I.P. Hws

Comments:/Conditions: Checked tanks, lines & pressure 2/25/2002

1"=50' INITIAL SITE SKETCH

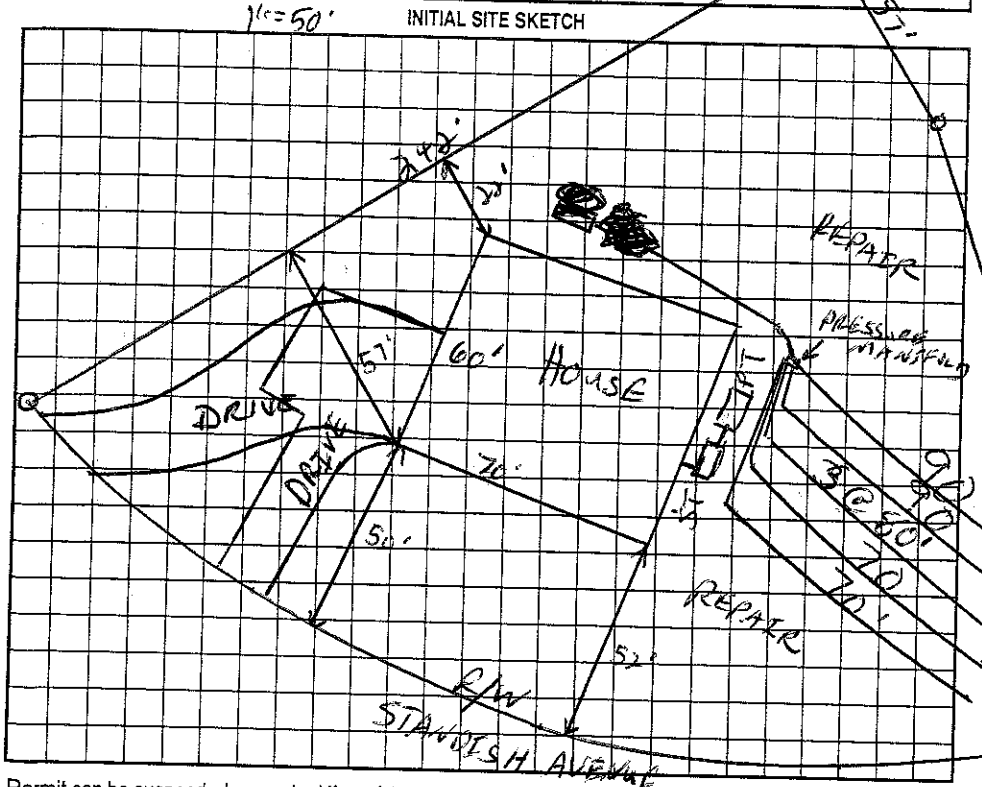

AS BUILT SKETCH

Installed essentially as Drawn Used EZ Flow Drainfield

Permit can be suspended or revoked if any false information is supplied toward securing the permit/any unauthorized changes are made to the site/any unauthorized changes are made in the installation of the system. Improvement Permit with plat valid without expiration. Improvement Permit with site plan valid for sixty months. Authorization to Construct is valid for a period equal to that of Improvement Permit – not to exceed sixty months.

Signed: [signature] (Agent) date 10/25/00

Improvement Permit by: [signature] RS date 10/24/00

Authorization to Construct by: Wesley Sparks RS. date 10/26/01

Installed by: Hallman Construction

Operation Permit by: Wesley Sparks RS. date 4/17/02

Existing System Inspection by: date

HEALTH DEPT. COPY: WHITE OWNER COPY (FINAL): YELLOW OWNER COPY (INITIAL): PINK