IREDELL COUNTY HEALTH DEPARTMENT

STATESVILLE 704-878-5305 MOORESVILLE 704-664-5281

IMPROVEMENT PERMIT / AUTHORIZATION TO CONSTRUCT / OPERATION PERMIT / EXISTING SYSTEM INSPECTION

$345 2:00

PERMIT# 0949260 PIN# ~~4625-94-1684 (pt)~~ 4625-63-6022 Dan DATE 7/1/2002

OWNER OR CONTRACTOR Arcadia Homes/CRI PHONE: Business 8894663 Home 201-7181

ADDRESS P.O. Box 471941 Charlotte, NC 28247

LOCATION Brawley School Rd TR Attleboro on right

SUBDIVISION The Point BLOCK / SECTION 7 LOT 708 LOT AREA 33,431 ft² SITE CLASS. PS DESIGN FLOW 600gpd T.A.R. 3

Septic Tank: 1500 Gallons; STB 338 Date 2-17-03

Pump Tank: 1500 Gallons; PT 338 Date 9-21-02

Pump Make: _____ Model _____ Serial No. _____

Nitrification Field: No Fields 1 Square Feet 1020' Linear Feet 340'

No Lines 4@85' Trench Width 24"-36" Max Trench Bottom Depth 30" Gravel Depth N/A

[X] New System [ ] Repair System Type: I, II, III, IV, V, VI

System Description: Pump LP-Panel

Repair System Description: Same

Maintenance Agreement Required: [X] Yes [ ] No

[X] House/Mod. Home [ ] Mobile Home [ ] Business [ ] Other

No. Bedrooms 5 No. Bathrooms 6½ No. Employees ____


[ ] Slab [X] Crawl Space [X] Basement w/plumbing [ ] Basement wo/plumbing

Water Supply: [ ] Individual [X] Public [X] Community


Comments:/Conditions: Keep Septic System at least 10' From PL and 50' From lake. Keep Repair area at least 25' From Basement

Comments:/Conditions: partial Tanks checked 4/4/03
50% Reduction in Drainfield area.
~~19-20~~ panels per ditch.
Pressure, electrical & alarm checked 4/25/03

INITIAL SITE SKETCH Scale 1:50

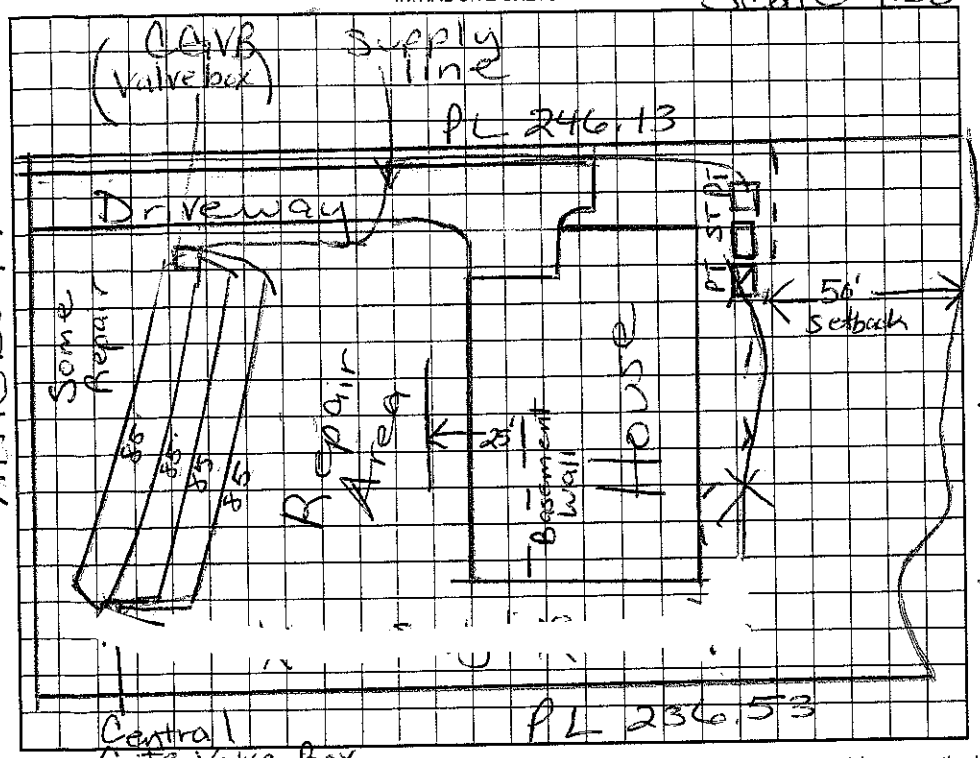

AS BUILT SKETCH

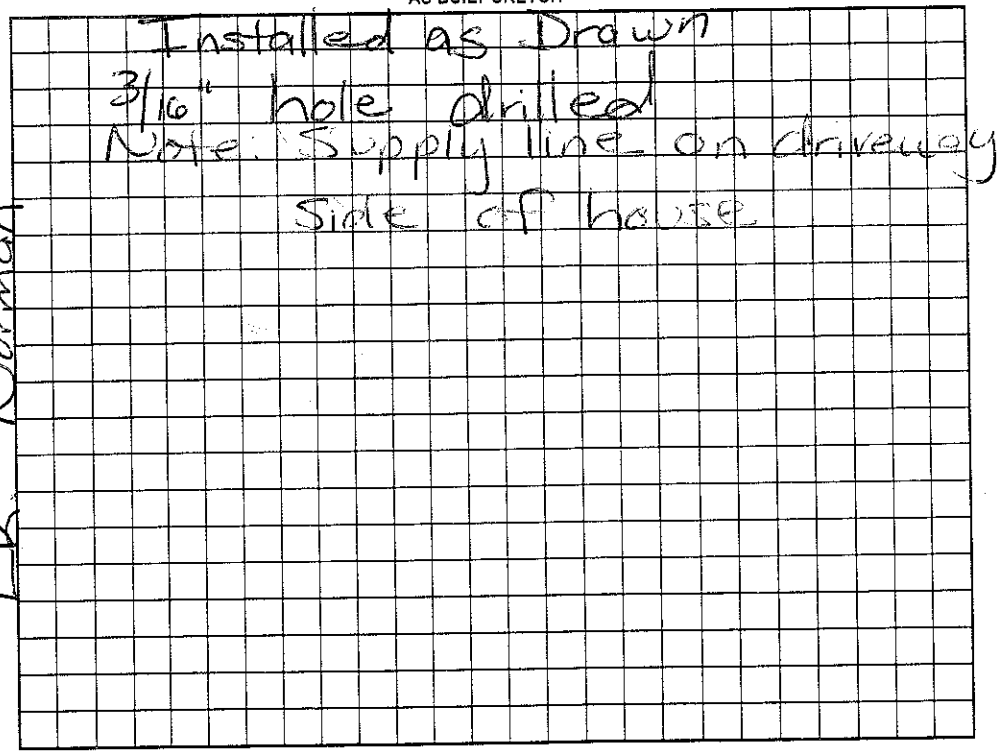

Permit can be suspended or revoked if any false information is supplied toward securing the permit/any unauthorized changes are made to the site/any unauthorized changes are made in the installation of the system. Improvement Permit with plat valid without expiration. Improvement Permit with site plan valid for sixty months. Authorization to Construct is valid for a period equal to that of Improvement Permit – not to exceed sixty months.

Signed: _____ date 7-3/2002 Installed by: R&H RS

Improvement Permit by: Maria H. Dotson RS date 7/2/2002 Operation Permit by: Maria H. Dotson RS date 4/25/03

Authorization to Construct by: Maria H. Dotson RS date 7/2/2002 Existing System Inspection by: _____ date _____

HEALTH DEPT. COPY: WHITE OWNER COPY (FINAL): YELLOW OWNER COPY (INITIAL): PINK