IREDELL COUNTY HEALTH DEPARTMENT

STATESVILLE 704-878-5305 500.00 Paid MOORESVILLE 704-664-5281

IMPROVEMENT PERMIT / AUTHORIZATION TO CONSTRUCT / OPERATION PERMIT / EXISTING SYSTEM INSPECTION

PERMIT# 90751 PIN# ~~4625941687 AT~~ 4625-63-6597 DATE 2/12/01

OWNER OR CONTRACTOR CRESCENT RESOURCES/BRAVESHARE HOMES PHONE: Business 663-6905 Home

ADDRESS PO Box 1003 CHARLOTTE

LOCATION BRAWLEY SCHOOL - TR STONEWALL BEACH - TR STANOLSH AVE - ON RT

SUBDIVISION POINT BLOCK / SECTION 6 LOT 622 LOT AREA 48562 ft² SITE CLASS PS DESIGN FLOW 480GPD L.T.A.R. .36GPD/FT²

Septic Tank: 1500+ Gallons; STB 338 Date 9/23/01
Pump Tank: 1500 T Gallons; PT 338 Date 9/5/01
Pump Make: Bowlby Model WE1512HH Serial No. 502692481
Nitrification Field: No Fields 1 Square Feet 600 Linear Feet 300
No Lines 3@100' Trench Width 24" Max Trench Bottom Depth 36" Gravel Depth N/A

☑ New System ☐ Repair System Type: I. II. III. IV. V. VI
System Description: LPP AVEC/OFFSITE
Repair System Description: SAME/OFFSITE
Maintenance Agreement Required: ☑ Yes ☐ No

☑ House/Mod. Home No. Bedrooms 4
☐ Mobile Home No. Bathrooms 4
☐ Business No. Employees
☐ Other
☐ Slab ☐ Crawl Space ☑ Basement w/plumbing ☐ Basement wo/plumbing


Water Supply: ☐ Individual ☐ Public ☑ ~~Community~~

Comments:/Conditions:


The location of the proposed Bath & Kitchen addition does not appear to impact the existing septic system.
**NOTE: No additional Bedrooms

Tracy Mulvilee REHS
Date: 8-22-12
ICHD-Environmental Health Division

Comments:/Conditions:

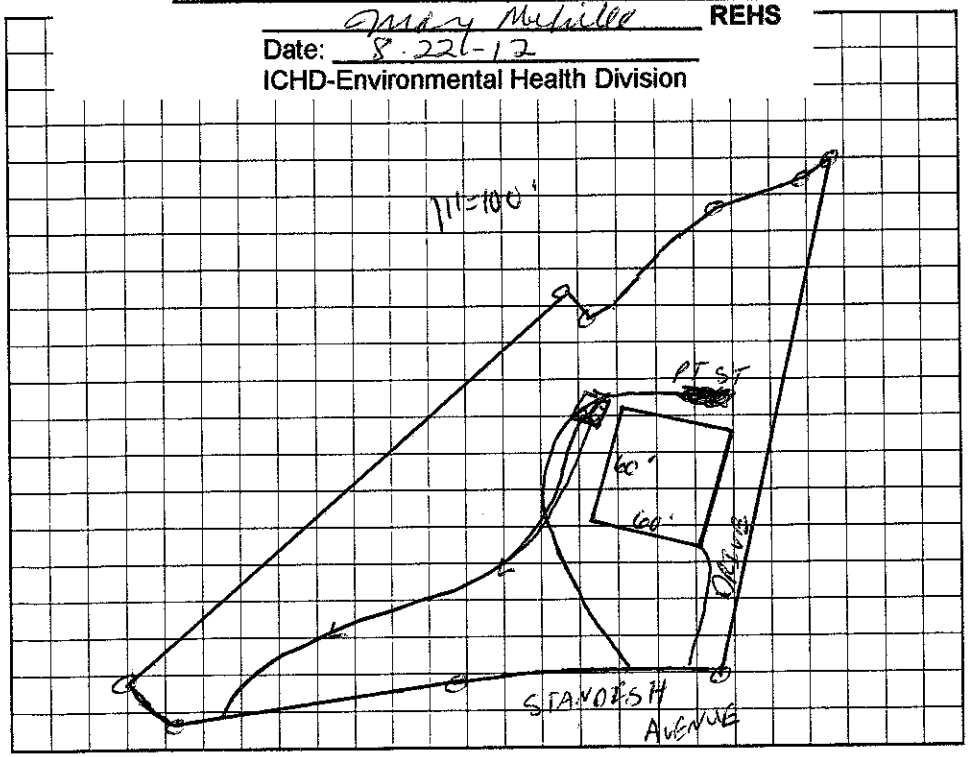

AS BUILT SKETCH

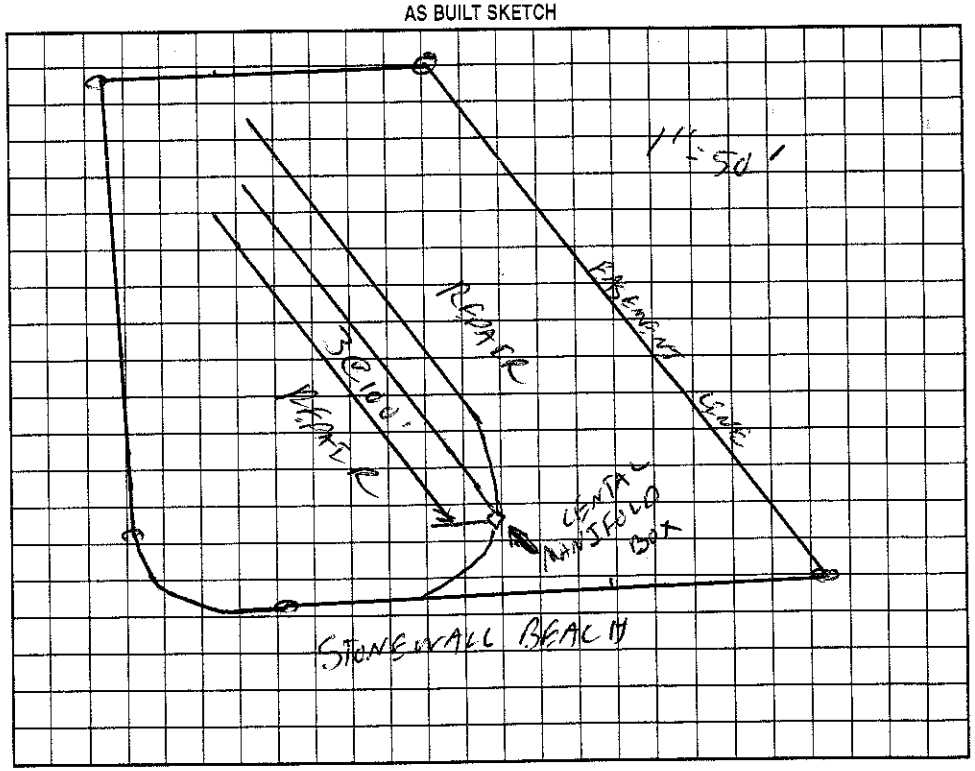

Permit can be suspended or revoked if any false information is supplied toward securing the permit/any unauthorized changes are made to the site/any unauthorized changes are made in the installation of the system. Improvement Permit with plat valid without expiration. Improvement Permit with site plan valid for sixty months. Authorization to Construct is valid for a period equal to that of Improvement Permit – not to exceed sixty months.

Signed: [signature] date 2/15/01 Installed by: Hallman Const.

Improvement Permit by: C. [signature] RS date 2/12/01 Operation Permit by: Wesley Sparks R.S. date 1/11/02

Authorization to Construct by: C. [signature] RS date 2/12/01 Existing System Inspection by: date

HEALTH DEPT. COPY: WHITE OWNER COPY (FINAL): YELLOW OWNER COPY (INITIAL): PINK