IREDELL COUNTY HEALTH DEPARTMENT

STATESVILLE 704-878-5305 MOORESVILLE 704-664-5281

IMPROVEMENT PERMIT / AUTHORIZATION TO CONSTRUCT / OPERATION PERMIT / EXISTING SYSTEM INSPECTION

PERMIT# 90776 PIN# 4625 94 1684 OF 4625 63 7805 DATE 10/24/00

OWNER OR CONTRACTOR CRESCENT RESOURCES / DIBBLE PHONE: Business 663 6905 Home

ADDRESS PO Box 1003 CHARLOTTE NC 28201

LOCATION BRAWLEY SCHOOL - TR STONEWALL BEACH - TR 1ST STANDISH - ON LT 161 Standish

SUBDIVISION POINT BLOCK / SECTION 6 LOT 646 LOT AREA 30845 ± SITE CLASS. PS DESIGN FLOW 480GPD L.T.A.R. 1,300/1FT²

Septic Tank: ~~1000~~ 1500 Gallons; STB 338 Date 7-14-61

Pump Tank: Gallons; PT Date

Pump Make: Model Serial No.

Nitrification Field: No Fields 1 Square Feet 1200 Linear Feet 400

No Lines 4@100 Trench Width 36" Max Trench Bottom Depth 36" Gravel Depth N/A

☑ New System ☐ Repair System Type: I, II, (III) IV, V, VI

System Description: GRAVITY 25% REDUCTION

Repair System Description: PUMP LP PANEL

Maintenance Agreement Required: ☐ Yes ☑ No

☑ House/Mod. Home No. Bedrooms 4

☐ Mobile Home No. Bathrooms 4

☐ Business No. Employees

☐ Other

☐ Slab ☑ Crawl Space ☐ Basement w/plumbing ☐ Basement wo/plumbing

Water Supply: ☐ Individual ☐ Public ☐ ~~Community~~


Comments:/Conditions: 1) REMOVE TERRACES AND BERMS

2) WELL ~~NEED~~ ON LOT 645 TO BE ABANDONED PROPERLY BEFORE OPERATION PERMIT CAN BE ISSUED.

Comments:/Conditions: Polylok Filter Installed

REVIEWED HOUSE PLAN 3/23/01 - 4BR

INITIAL SITE SKETCH 1" = 50'

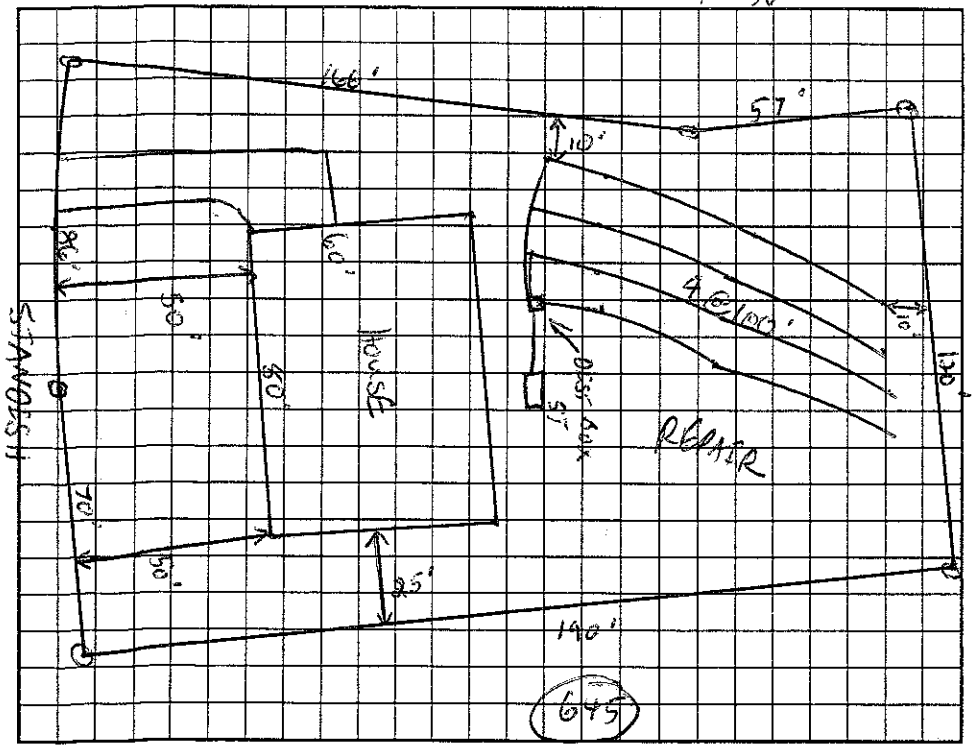

AS BUILT SKETCH

Installed as Drawn EZ Flow installed

Permit can be suspended or revoked if any false information is supplied toward securing the permit/any unauthorized changes are made to the site/any unauthorized changes are made in the installation of the system. Improvement Permit with plat valid without expiration. Improvement Permit with site plan valid for sixty months. Authorization to Construct is valid for a period equal to that of Improvement Permit – not to exceed sixty months.

Signed: [signature], HS Agent date 10/25/00

Improvement Permit by: [signature] HS date 10/24/00

Authorization to Construct by: [signature] HS date 2/23/01

Installed by: Wayne Dorbison

Operation Permit by: [signature] RS. date 8/28/2001

Existing System Inspection by: date

HEALTH DEPT. COPY: WHITE OWNER COPY (FINAL): YELLOW OWNER COPY (INITIAL): PINK