IREDELL COUNTY HEALTH DEPARTMENT

STATESVILLE 704-878-5305 MOORESVILLE 704-664-5281

Redraw $5 — 11:30

IMPROVEMENT PERMIT / AUTHORIZATION TO CONSTRUCT / OPERATION PERMIT / EXISTING SYSTEM INSPECTION

PERMIT# 90742 PIN# ~~4625944684 PT~~ 4625-64-2226 DATE 9/30/2002

OWNER OR CONTRACTOR Hughes, Hamelink & Zande PHONE: Business (704) 375-5999 Home

ADDRESS 909 East Blvd. Charlotte, NC 28203

LOCATION Brawley School TR Stonewall Beach TR Standish on left

SUBDIVISION Point J BLOCK / SECTION 6 LOT 615 LOT AREA 47458 ft² SITE CLASS PS DESIGN FLOW 480 gpd L.T.A.R. .3

Septic Tank: 1000± Gallons; STB 338 Date 6-2-03 ☒ New System ☐ Repair System Type: I, II, III, IV, V, VI

Pump Tank: 1000 Gallons; PT 27 Date 5-27-03 System Description: Pump-LP-Panel Blk

Pump Make: Meyers Model 1/3 HP Serial No. Repair System Description: Same

Nitrification Field: No Fields 1 Square Feet 840 Linear Feet 280' Maintenance Agreement Required: ☒ Yes ☐ No

No Lines 4@70' Trench Width 24"-36" Max Trench Bottom Depth 36" Gravel Depth N/A

☒ House/Mod. Home No. Bedrooms 4 ☐ Mobile Home No. Bathrooms 5½ ☐ Business No. Employees ☐ Other

☐ Slab ☒ Crawl Space ☐ Basement w/plumbing ☐ Basement wo/plumbing


Water Supply: ☐ Individual ☒ Public ☒ Community

Comments/Conditions: Keep Septic System at least 10' from & 50' from lake.


Comments/Conditions: Checked lines 8/28/03 Checked tanks & pressure 3/4/04

Scale 1:40

INITIAL SITE SKETCH

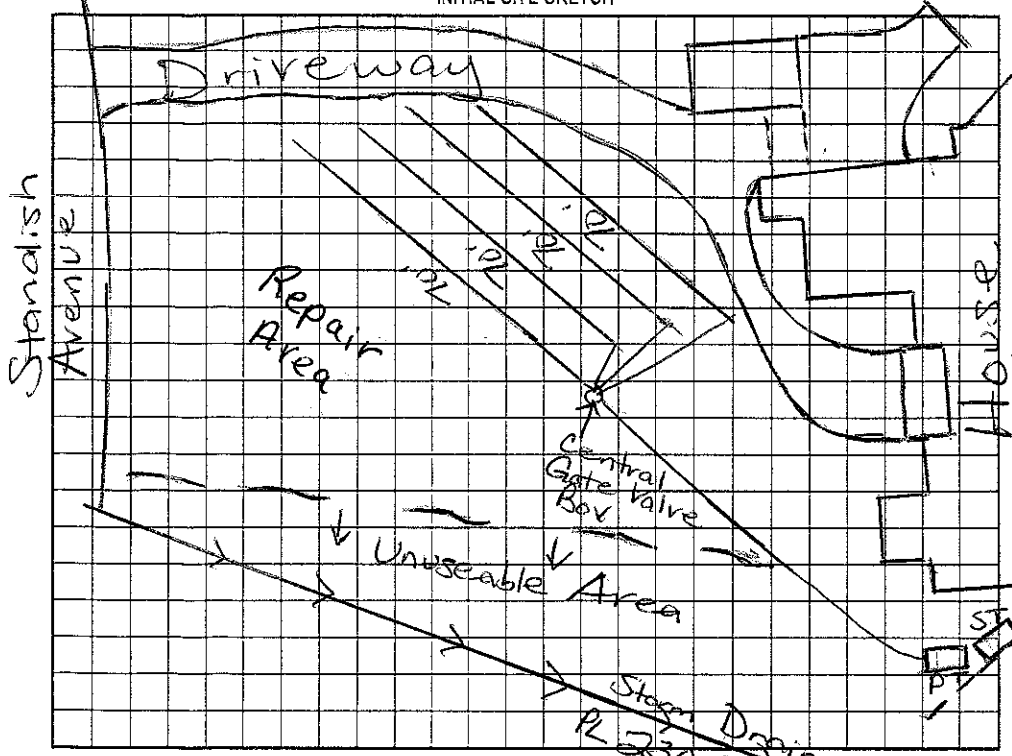

AS BUILT SKETCH

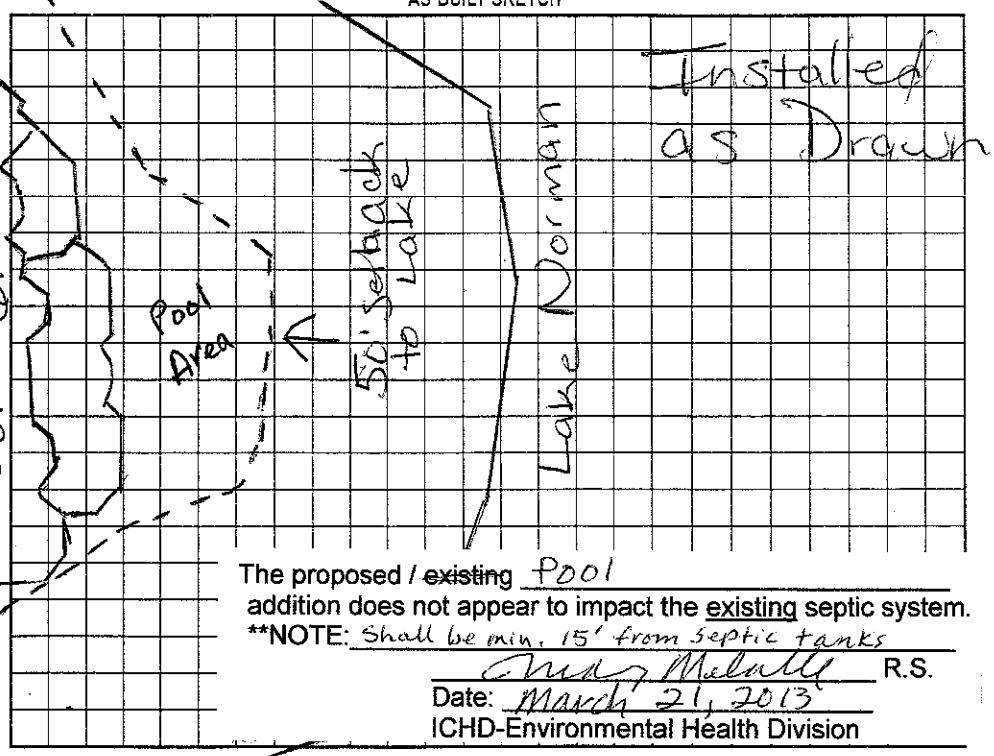

The proposed / ~~existing~~ Pool addition does not appear to impact the existing septic system.

**NOTE: Shall be min. 15' from septic tanks

Cindy Mahaffey R.S.

Date: March 21, 2013

ICHD-Environmental Health Division

Permit can be suspended or revoked if any false information is supplied toward securing the permit/any unauthorized changes are made to the site/any unauthorized changes are made in the installation of the system. Improvement Permit with plat valid without expiration. Improvement Permit with site plan valid for sixty months. Authorization to Construct is valid for a period equal to that of Improvement Permit – not to exceed sixty months.

Signed: _____ date _____ Installed by: Bobby Mayhew RS

Improvement Permit by: Maria H. Dotson RS date 9/30/02 Operation Permit by: Maria H. Dotson RS date 3/5/04

Authorization to Construct by: Maria H. Dotson RS date 9/30/02 Existing System Inspection by: _____ date _____

HEALTH DEPT. COPY: WHITE OWNER COPY (FINAL): YELLOW OWNER COPY (INITIAL): PINK