IREDELL COUNTY HEALTH DEPARTMENT

STATESVILLE 704-878-5305 MOORESVILLE 704-664-5281

IMPROVEMENT PERMIT / AUTHORIZATION TO CONSTRUCT / OPERATION PERMIT / EXISTING SYSTEM INSPECTION

PERMIT# 090708 PIN# ~~4625 94 1684~~ 4625-64-3337 DATE 6/3/03

OWNER OR CONTRACTOR August Homes PHONE: Business 704-892-7995 Home

ADDRESS 10602 Bagley Rd Cornelius NC 28031

LOCATION Bagley Sch, TR Stonewall Beach, TR Standish on Rt # 124 Standish

SUBDIVISION Point BLOCK / SECTION 6 LOT 614 LOT AREA 35,941 Ft² SITE CLASS. PS DESIGN FLOW 450 L.T.A.R. 0.3

Septic Tank: 1000 Gallons; STB 338 Date 5/26/03
Pump Tank: 1000 Gallons; PT 283 Date 5/26/03
Pump Make: Myers Model ME3 Serial No.
Nitrification Field: No Fields 1 Square Feet 840 Linear Feet 280
No Lines 4 @ 70' Trench Width 36" Max Trench Bottom Depth 36" Gravel Depth —

☒ New System ☐ Repair System Type: I, II, III, (IV), V, VI
System Description: LP Panel Block
Repair System Description: 5 Pane
Maintenance Agreement Required: ☒ Yes ☐ No


☒ House/Mod. Home No. Bedrooms 4
☐ Mobile Home No. Bathrooms 4
☐ Business No. Employees
☐ Other
☐ Slab ☐ Crawl Space ☒ Basement w/plumbing ☐ Basement wo/plumbing

Water Supply:
☐ Individual
☐ Public
☒ Community


Comments:/Conditions: * Sewage pump + 10FT 4" pipe to be Installed to Section 712.4 of plumbing code (see Attached Letter + Code page)

Comments:/Conditions: Tanks & lines Checked 7/15/03
Pressure, elect & alarm 9/8/03

INITIAL SITE SKETCH

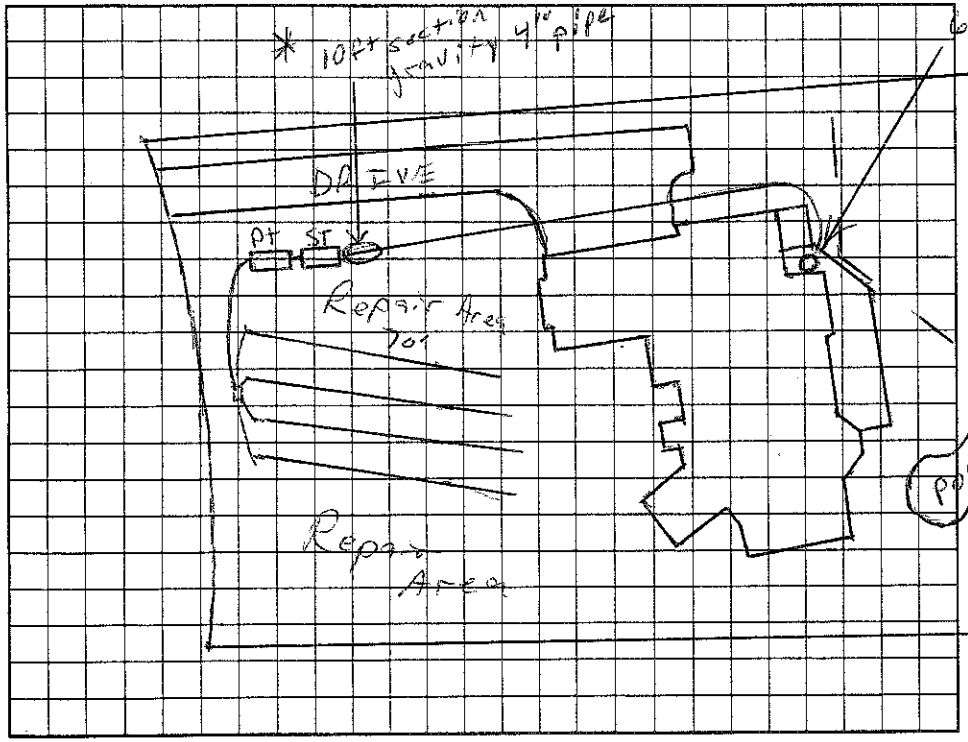

AS BUILT SKETCH

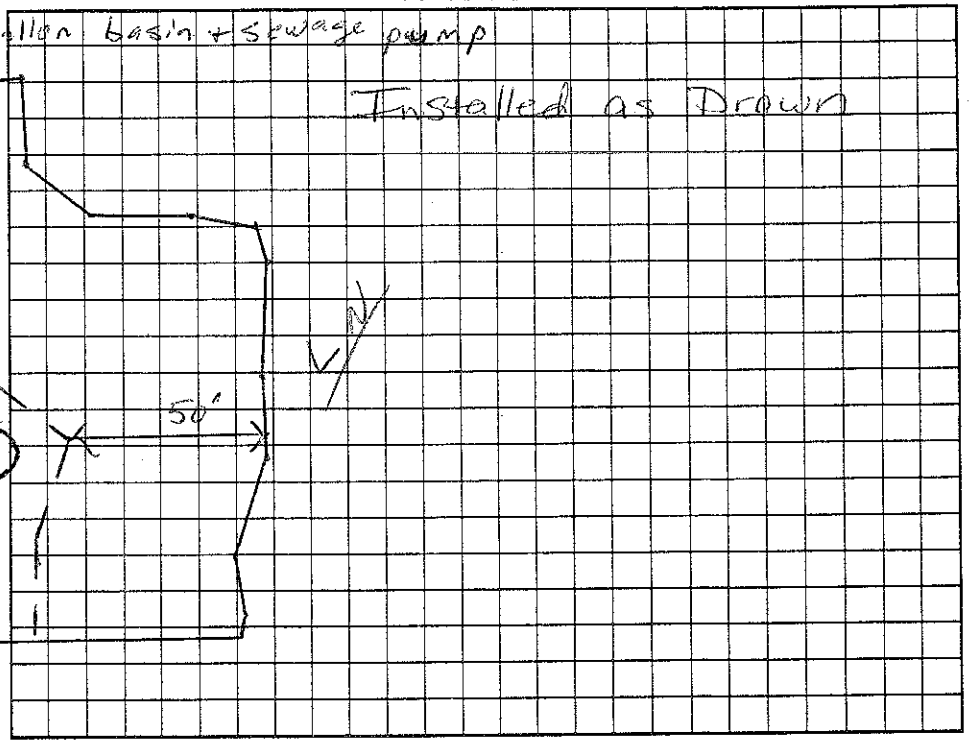

Permit can be suspended or revoked if any false information is supplied toward securing the permit/any unauthorized changes are made to the site/any unauthorized changes are made in the installation of the system. Improvement Permit with plat valid without expiration. Improvement Permit with site plan valid for sixty months. Authorization to Construct is valid for a period equal to that of Improvement Permit – not to exceed sixty months.

Signed: [signature] RS date 6/3/03
Improvement Permit by: [signature] RS date 6/3/03
Authorization to Construct by: [signature] RS date 6/3/03

Installed by: R & H RS
Operation Permit by: Mana & H Dotson date 9/8/03
Existing System Inspection by: date

HEALTH DEPT. COPY: WHITE OWNER COPY (FINAL): YELLOW OWNER COPY (INITIAL): PINK