IREDELL COUNTY HEALTH DEPARTMENT

STATESVILLE 704-878-5305 MOORESVILLE 70[illegible]

IMPROVEMENT PERMIT / AUTHORIZATION TO CONSTRUCT / OPERATION PERMIT / EXISTING SYSTEM INSPECTIO

PERMIT# 90707 PIN# 4625944684 PT Dan 4625-64-4455 DATE 12-10-20[illegible]

OWNER OR CONTRACTOR Arcadia Homes PHONE: Business 201-7181 Home

ADDRESS P.O. Box 471941 Charlotte NC 28247

LOCATION Brawley School Rd TR Stonewall Beach TR Standish on Rt

SUBDIVISION The Point BLOCK / SECTION 6 LOT 613 LOT AREA 38336 SITE CLASS PS DESIGN FLOW 600gpd L.T.A.R. .3

Septic Tank: 1500 Gallons; STB 338 Date 5-7-04
Pump Tank: 1500 Gallons; PT 421 Date 4-5-04
Pump Make: Model Serial No.
Nitrification Field: No Fields 1 Square Feet 1020' Linear Feet 340'
No Lines 4@85' Trench Width 36" Max Trench Bottom Depth 30'-36" Gravel Depth N/A

☒ New System ☐ Repair System Type: I, II, III, IV, V, VI
System Description: Pressure LP Panel Blk
Repair System Description: Same.
Maintenance Agreement Required: ☒ Yes ☐ No


☒ House/Mod. Home No. Bedrooms 5
☐ Mobile Home No. Bathrooms 5.5
☐ Business No. Employees
☐ Other
☐ Slab ☒ Crawl Space ☒ Basement w/plumbing ☐ Basement wo/plumbing

Water Supply: ☐ Individual ☒ Public ☒ Community

Comments/Conditions: Remove terraces & berms. Start drainlines 10' off PL & stay 15' off gullied "Not Useable" area. Reviewed Building plans 10/23/03. MD

Comments/Conditions: Note: line closest to house may be shorter than 85' okay to make upon other lines. Okay to relocate tanks as long as setbacks are maintained. Checked tanks & lines 6/10/04

INITIAL SITE SKETCH Scale 1:50'

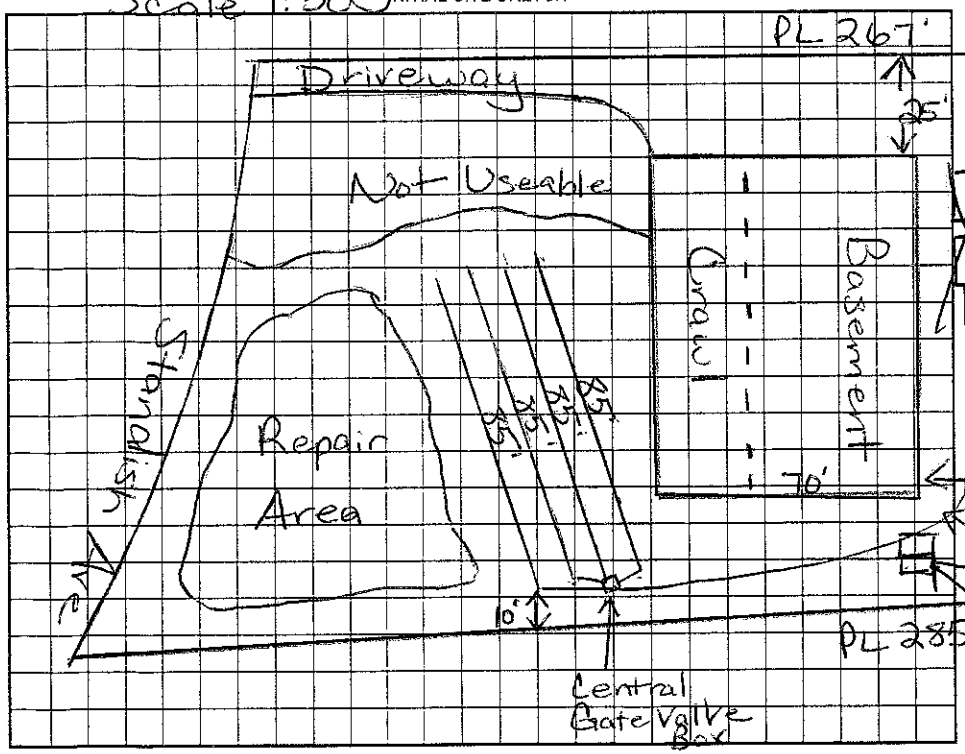

AS BUILT SKETCH Pres, elect & alarm 8/11/04

8-11-04

Permit can be suspended or revoked if any false information is supplied toward securing the permit/any unauthorized changes are made to the site/any unauthorized changes are made in the installation of the system. Improvement Permit with plat valid without expiration. Improvement Permit with site plan valid for sixty months. Authorization to Construct is valid for a period equal to that of Improvement Permit – not to exceed sixty months.

Signed: date 12/12/02 Installed by: R & H

Improvement Permit by: Maina H H Dotson RS date 12/11/2002 Operation Permit by: Maina H H Dotson RS date 8/11/04

Authorization to Construct by: Maina H H Dotson RS date 6/23/03 Existing System Inspection by: date

HEALTH DEPT. COPY: WHITE OWNER COPY (FINAL): YELLOW OWNER COPY (INITIAL): PINK