11:30

IREDELL COUNTY HEALTH DEPARTMENT

STATESVILLE 704-878-5305 MOORESVILLE 704-664-5281

IMPROVEMENT PERMIT / AUTHORIZATION TO CONSTRUCT / OPERATION PERMIT / EXISTING SYSTEM INSPECTION

PERMIT# 90778 PIN# 4625 94 1684 PT 4625 64 5001 DATE 10/24/00

OWNER OR CONTRACTOR CRESCENT RESOURCES/HUGHES HAMELINK & LANDE PHONE: Business 663-6905 Home

ADDRESS PO Box 1003 CHARLOTTE NC 28201

LOCATION BRAWLEY SCHOOL - TR STONEWALL BEACH - 1ST SPANDISH - ON LT 139 Standish Ln.

SUBDIVISION POINT BLOCK / SECTION 6 LOT 648 LOT AREA 33429 SITE CLASS. PS DESIGN FLOW 480GPD L.T.A.R. .36GPD/FT²

Septic Tank: 1000+ Gallons; STB 1500 Date 2/26/02
Pump Tank: 1000+ Gallons; PT 1000 Date 3/10/02
Pump Make: _____ Model _____ Serial No. _____
Nitrification Field: No Fields 1 Square Feet 1200 Linear Feet 400
No Lines 4@100' Trench Width 36" Max Trench Bottom Depth 36" Gravel Depth n/a

☑ New System ☐ Repair System Type: I, II, (III), IV, V, VI
System Description: PUMP 25% REDUCTION
Repair System Description: LP PANEL
Maintenance Agreement Required: ☐ Yes ☑ No

☑ House/Mod. Home No. Bedrooms 4
☐ Mobile Home No. Bathrooms 4
☐ Business No. Employees ____
☐ Other ____

☐ Slab ☑ Crawl Space ☐ Basement w/plumbing ☐ Basement wo/plumbing


Water Supply: ☐ Individual ☐ Public ☑ Community

Comments:/Conditions: REMOVE TERRACES AND BERMS

* PLANS SHOW 4BR ** 10/3/01


Comments:/Conditions: Checked upper 3 drainlines 4/12/02
4th line checked 4/18/02 by WS
Pres. Checked 5/30/02 Elect. alarm Checked 5/30/02

INITIAL SITE SKETCH 1"=50'

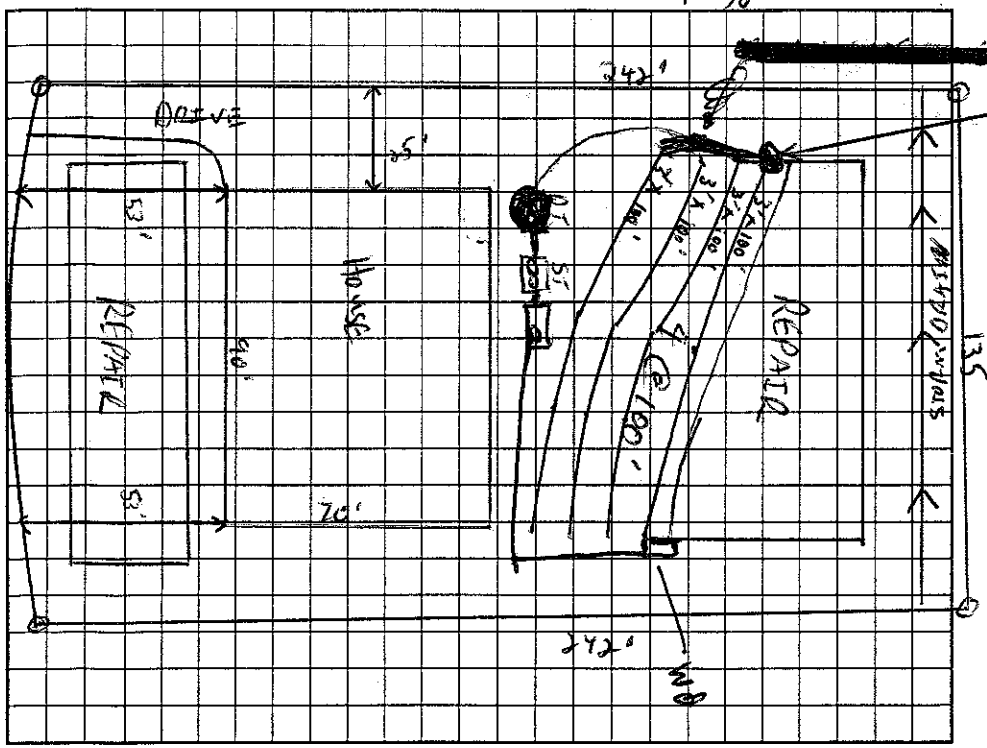

AS BUILT SKETCH

EZ Flow Drainfield Installed

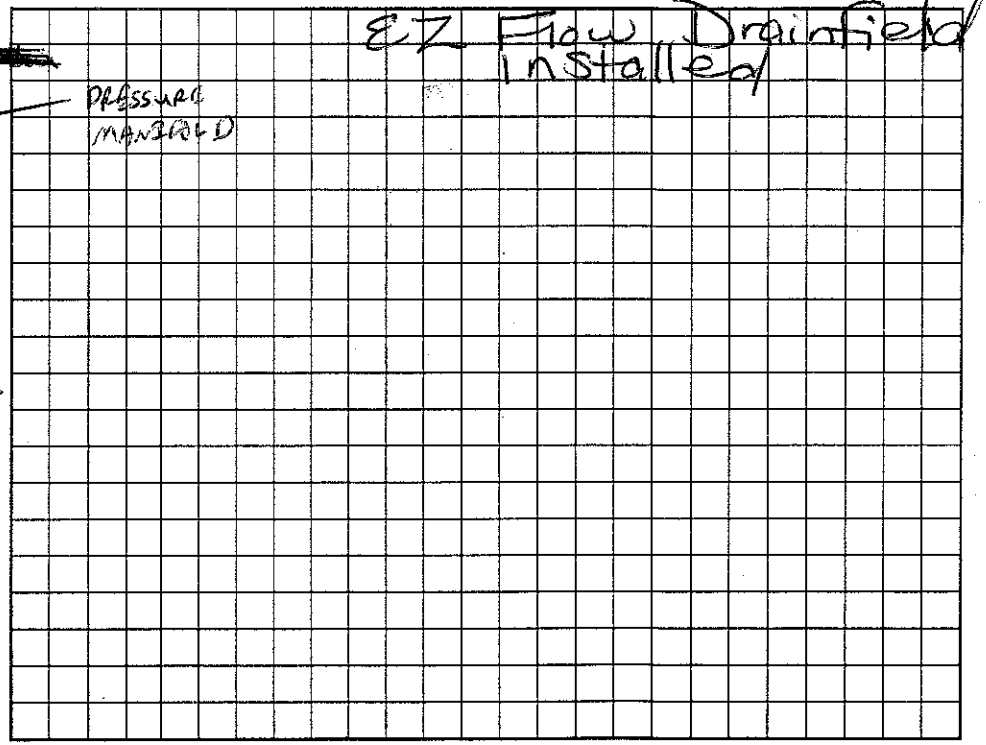

Permit can be suspended or revoked if any false information is supplied toward securing the permit/any unauthorized changes are made to the site/any unauthorized changes are made in the installation of the system. Improvement Permit with plat valid without expiration. Improvement Permit with site plan valid for sixty months. Authorization to Construct is valid for a period equal to that of Improvement Permit – not to exceed sixty months.

Signed: _____ date 10/3/01

Improvement Permit by: _____ date 10/24/00

Authorization to Construct by: _____ date 10/3/01

Installed by: Bobby Mayberry

Operation Permit by: _____ date 5/3

Existing System Inspection by: _____ date _____

HEALTH DEPT. COPY: WHITE OWNER COPY (FINAL): YELLOW OWNER COPY (INITIAL): PINK