COUNTY HEALTH DEPARTMENT

ATESVILLE 704-878-5305 MOORESVILLE 704-664-5281

VEMENT PERMIT / AUTHORIZATION TO CONSTRUCT / OPERATION PERMIT / EXISTING SYSTEM INSPECTION

2100

PERMIT# 90780 PIN# 462 594 1684 PT 4625 646 241

OWNER OR CONTRACTOR CRESCENT RESOURCES / Dienst PHONE: Business 667 6005 Home DATE 10/24/00

ADDRESS PO BOX 1003 CHARLOTTE NC 28201

LOCATION BRAWLEY SCHOOL - TR STONEWALL BEACH - TR 1ST STANDISH - ON LT

SUBDIVISION POINT BLOCK / SECTION 6 LOT 650 LOT AREA 33048 ft² SITE CLASS. PS DESIGN FLOW 480GPD L.T.A.R. .30GPD/FT²

Septic Tank: 1000+ Gallons; STB 421 Date 11-29-03

Pump Tank: 1000+ Gallons; PT 283 Date 12-7-03

1/3+ Pump Make: Gould's Model Serial No.

Nitrification Field: No Fields 1 Square Feet 810 Linear Feet 270

No Lines 3@90' Trench Width 36" Max Trench Bottom Depth 36" Gravel Depth N/A

☑ New System ☐ Repair System Type: I, II, III, IV, V, VI

System Description: PUMP UP PANEL

Repair System Description: SAME

Maintenance Agreement Required: ☑ Yes ☐ No

☑ House/Mod. Home ☐ Mobile Home ☐ Business ☐ Other

No. Bedrooms 4 No. Bathrooms 4 No. Employees

Water Supply: ☐ Individual ☐ Public ☑ Community

☐ Slab ☑ Crawl Space ☐ Basement w/plumbing ☐ Basement wo/plumbing


Comments:/Conditions: REMOVE TERRACES AND BERMS

Comments:/Conditions: Site plan Reviewed 8/19/03 - GM

House [redacted] is in Repair area slightly - original System may need to shift ≈ 5' uphill

Checked tanks & lines 11/15/04

1"=50' INITIAL SITE SKETCH

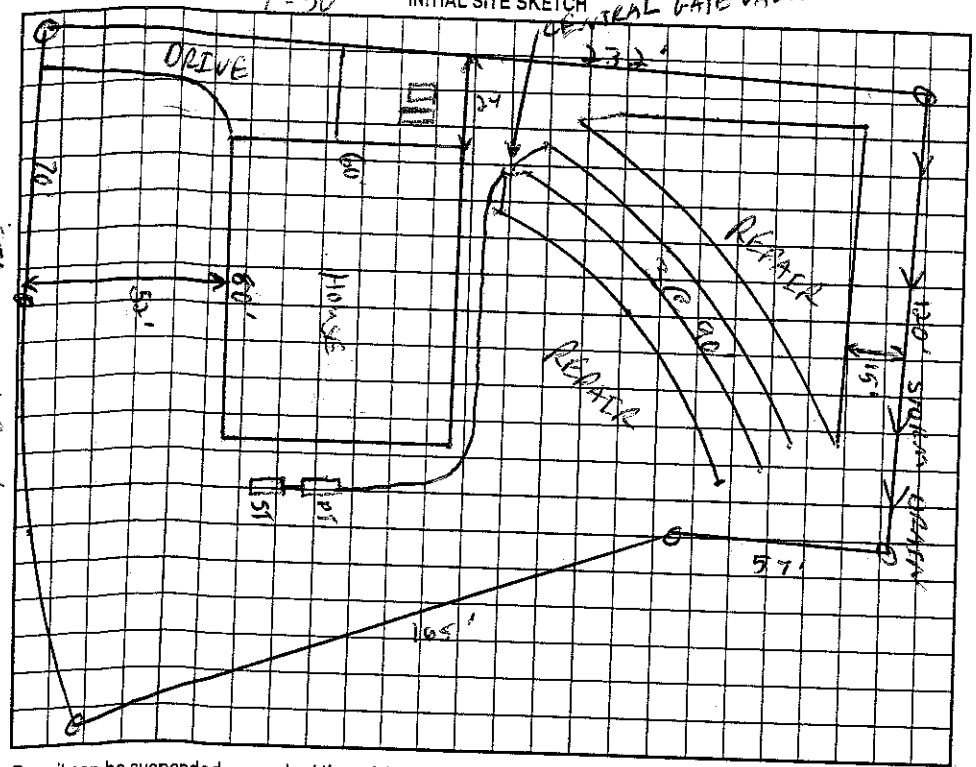

AS BUILT SKETCH

Installed as Drawn

Permit can be suspended or revoked if any false information is supplied toward securing the permit/any unauthorized changes are made to the site/any unauthorized changes are made in the installation of the system. Improvement Permit with plat valid without expiration. Improvement Permit with site plan valid for sixty months. Authorization to Construct is valid for a period equal to that of Improvement Permit – not to exceed sixty months.

Signed: [signature] date 10/25/00

Improvement Permit by: [signature] RS date 10/24/00

Authorization to Construct by: [signature] RS date 8/19/03

Installed by: R&H Inc RS

Operation Permit by: [signature] date 2/25/04

Existing System Inspection by: date

HEALTH DEPT. COPY: WHITE OWNER COPY (FINAL): YELLOW OWNER COPY (INITIAL): PINK