IREDELL COUNTY HEALTH DEPARTMENT

STATESVILLE 704-878-5305 MOORESVILLE 704-664-5281

IMPROVEMENT PERMIT / AUTHORIZATION TO CONSTRUCT / OPERATION PERMIT / EXISTING SYSTEM INSPEC.

PERMIT# 90774 PIN# ~~4625744684 PT~~ 4625-64-7065 DATE 10/24/00

OWNER OR CONTRACTOR CRESCENT RESOURCES / KENSWOOD HOMES PHONE: Business 667-6905 Home

ADDRESS PO Box 1003 CHARLOTTE NC 28201

LOCATION BRAWLEY SCHOOL - TR STONEWALL BEACH - ON RT PAST SIANOESH

SUBDIVISION POINT BLOCK / SECTION 6 LOT 644 LOT AREA 37468 SITE CLASS. PS DESIGN FLOW 480GPD L.T.A.R. .25gal/sq ft

Septic Tank: 1500 + Gallons; STB 338 Date 4/22/02
Pump Tank: 1000 T Gallons; PT 283 Date 4/23/02
Pump Make: Boulds Model WE0312MU Serial No. H0143639
Nitrification Field: No Fields 1 Square Feet 940 Linear Feet 330
No Lines 3@110' Trench Width 36" Max Trench Bottom Depth 36" Gravel Depth N/A

☑ New System ☐ Repair System Type: I, II, III, IV, V, VI
System Description: LP PANEL
Repair System Description: LP PANEL
Maintenance Agreement Required: ☑ Yes ☐ No

☑ House/Mod. Home No. Bedrooms 4
☐ Mobile Home No. Bathrooms 4
☐ Business No. Employees
☐ Other

☐ Slab ☑ Crawl Space ☐ Basement w/plumbing ☐ Basement wo/plumbing

Water Supply: ☐ Individual ☐ Public ☐ ~~Community~~


Comments:/Conditions: REMOVE TERRACES AND BERMS

* WALK THROUGH HOUSE BEFORE FINAL OPERATION PERMIT IS ISSUED *


Comments:/Conditions:

LA Panels installed -

INITIAL SITE SKETCH 1"=50'

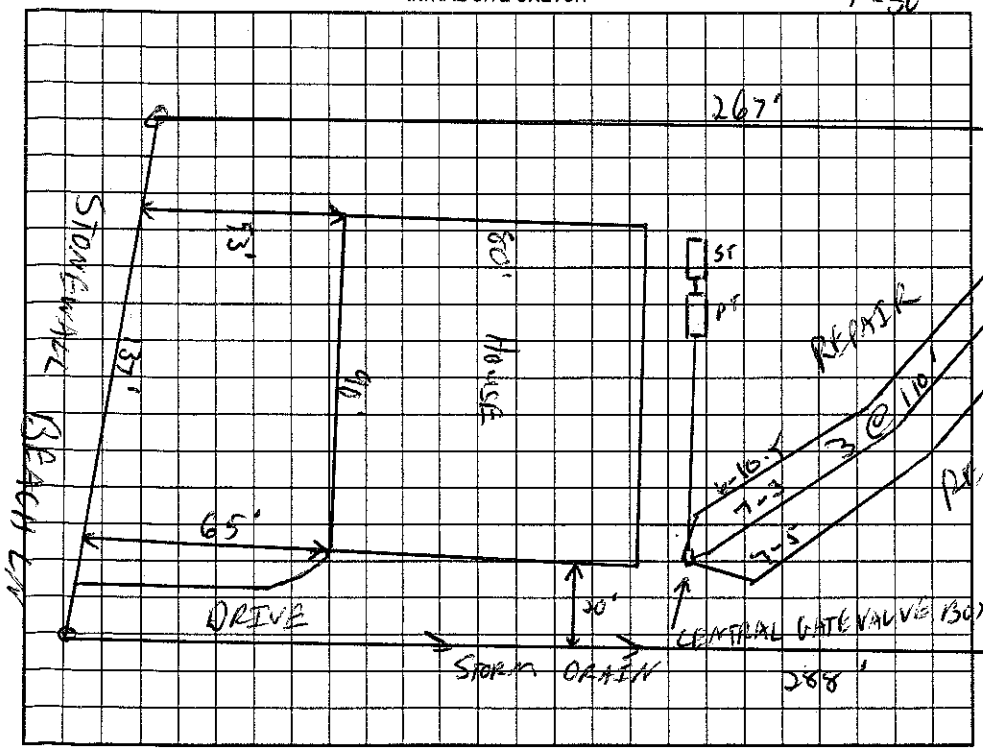

AS BUILT SKETCH

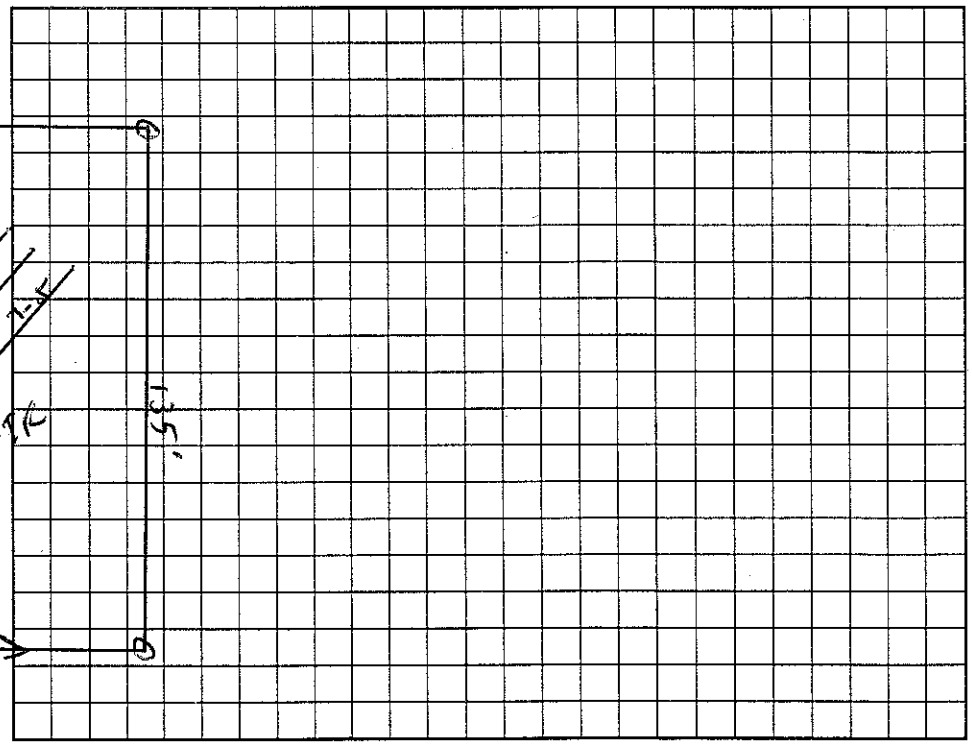

Permit can be suspended or revoked if any false information is supplied toward securing the permit/any unauthorized changes are made to the site/any unauthorized changes are made in the installation of the system. Improvement Permit with plat valid without expiration. Improvement Permit with site plan valid for sixty months. Authorization to Construct is valid for a period equal to that of Improvement Permit – not to exceed sixty months.

Signed: [signature] RS Agent date 10/25/00

Improvement Permit by: [signature] RS date 10/24/00

Authorization to Construct by: [signature] RS date 12/7/01

Installed by: Hallman Const. Co.

Operation Permit by: Wesley Sparks RS date 7/18/02

Existing System Inspection by: date

HEALTH DEPT. COPY: WHITE OWNER COPY (FINAL): YELLOW OWNER COPY (INITIAL): PINK