IREDELL COUNTY HEALTH DEPARTMENT — STATESVILLE 704-878-5305 — MOORESVILLE 704-664-5281

IMPROVEMENT PERMIT / AUTHORIZATION TO CONSTRUCT / OPERATION PERMIT / EXISTING SYSTEM INSPECTION

50.00 Paid 2:30

PERMIT# 90773/17224 PIN# 4625 94684 Pt. 4625648203 DATE 11/12/03

OWNER OR CONTRACTOR Bienst Custom Homes PHONE: Business 704-892-2426 Home

ADDRESS 9606A Caldwell Commons Cornelius, NC. 28031

LOCATION 1100 TR Stonewall Beach on corner of Standish Ln.

SUBDIVISION Point BLOCK / SECTION 6 LOT 643 LOT AREA .90 AC SITE CLASS PS DESIGN FLOW 600 L.T.A.R. .3

Septic Tank: 1500 Gallons; STB 338 Date 1-23-04
Pump Tank: 1500 Gallons; PT 3421 Date 1-31-04
Pump Make Gould's Model WE0312MV Serial No.
Nitrification Field: No Fields 1 Square Feet 1500 Linear Feet 500
No Lines 5@100 Trench Width 3' Max Trench Bottom Depth 3'

3

[X] New System [ ] Repair System Type: I, II, III, IV, V, VI
System Description: PressMan. to 25% Reduced
Repair System Description: LP to 16" PPBRS
Maintenance Agreement Required: [ ] Yes [X] No
Gravel Depth NA [ ] Slab [X] Crawl Space [ ] Basement w/plumbing [ ] Basement wo/plumbing


[X] House/Mod. Home No. Bedrooms 5
[ ] Mobile Home No. Bathrooms 4
[ ] Business No. Employees
[ ] Other

Water Supply: [ ] Individual [ ] Public [X] Community POINT


Comments/Conditions: * 25% Reduction Drainfield Materials Required; Storm Water Diversion Ditch required before Oper. Permit will be issued;

Comments/Conditions: Tanks checked 2/25/04
* Note: Power line ran just past end of drainlines interfers with part of repair. Checked drainlines 3/4/04 MD

INITIAL SITE SKETCH (1" = 50')

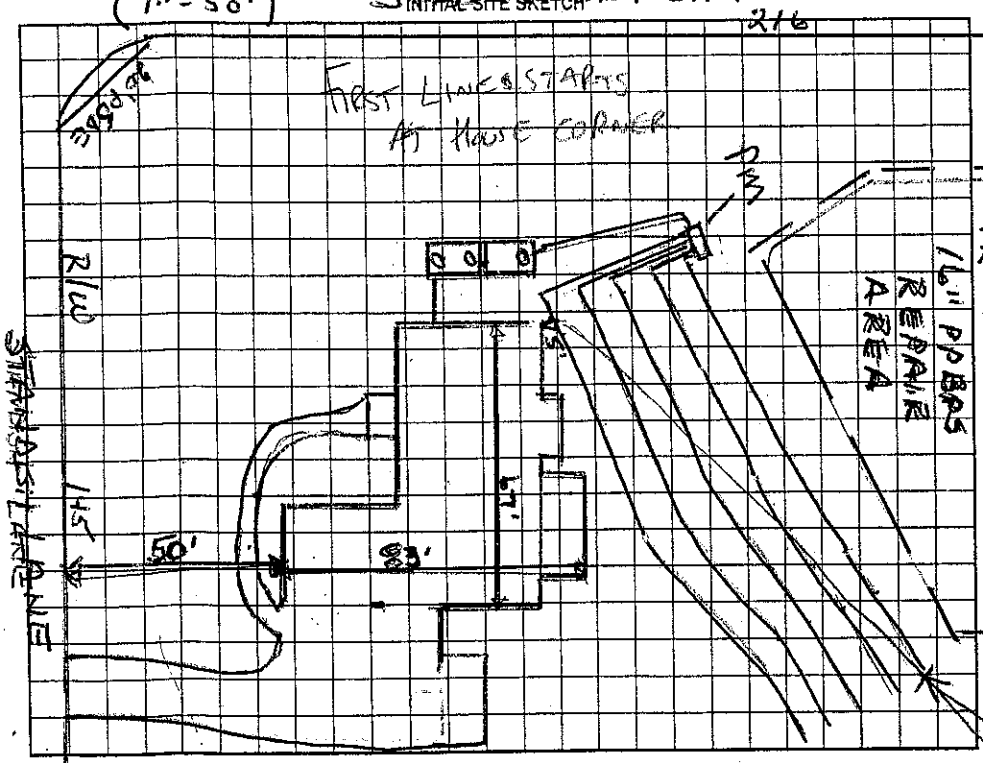

AS BUILT SKETCH

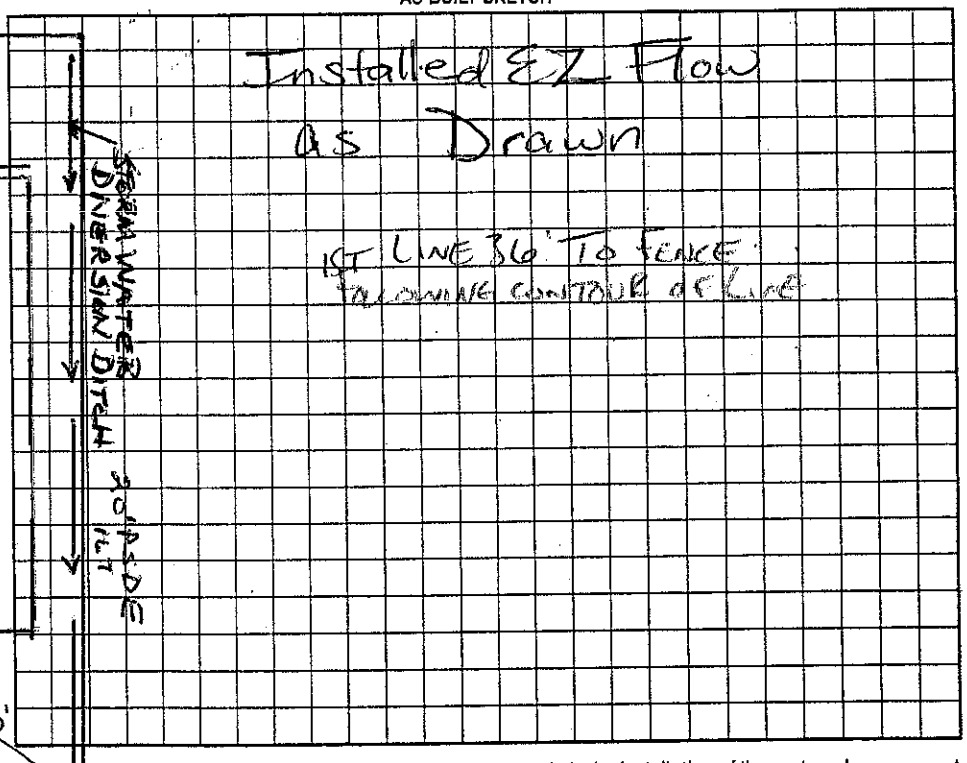

Permit can be suspended or revoked if any false information is supplied toward securing the permit/any unauthorized changes are made to the site/any unauthorized changes are made in the installation of the system. Improvement Permit with plat valid without expiration. Improvement Permit with site plan valid for sixty months. Authorization to Construct is valid for a period equal to that of Improvement Permit – not to exceed sixty months.

Signed: * date 11/14/03 Installed by: R & H

Improvement Permit by: C Brady Freeman R.S. date 10/23/03 Operation Permit by: date 4/22/04

Authorization to Construct by: Wesley Sparks R.S. date 11/12/03 Existing System Inspection by: date

HEALTH DEPT. COPY: WHITE OWNER COPY (FINAL): YELLOW OWNER COPY (INITIAL): PINK