IREDELL COUNTY HEALTH DEPARTMENT

$325

STATESVILLE 704-878-5305 MOORESVILLE 704-664-5281

IMPROVEMENT PERMIT / AUTHORIZATION TO CONSTRUCT / OPERATION PERMIT / EXISTING SYSTEM INSPECTION

PERMIT# 08136 / 12734 PIN# 4625446484 (Lot) Simonini Bldrs 4625-65-3049 DATE Sept. 23, '99

OWNER OR CONTRACTOR Freeset Resources Inc. // The Point on Norman PHONE: Business 660-1185 Home

ADDRESS 2214 Brawley Sch Rd. Mooresville

LOCATION Brawley Sch Rd. TR Polpis TL Jeremy Pt. TR Brick Kiln TL Union Chapel at end

SUBDIVISION The Point BLOCK / SECTION 5 LOT 539 LOT AREA 59,855 sf SITE CLASS PS DESIGN FLOW 480gpd L.T.A.R. n.3

Septic Tank: ~~1000~~ 1500 Gallons; STB 338 Date 7-23-99

Pump Tank: 1000 Gallons; PT 477 Date 7-17-99

Pump Make: Myers Model ME 50 Serial No.

Nitrification Field: No. Fields 1 Square Feet 900 Linear Feet 300

No Lines 4 Trench Width 36" Max Trench Bottom Depth 36" Gravel Depth NA

☑ New System ☐ Repair System Type: I, II, III, IV, V, VI

System Description: LPP Panel Block

Repair System Description: SAME

Maintenance Agreement Required: ☑ Yes ☐ No

☑ House/Mod. Home ☐ Mobile Home ☐ Business ☐ Other

No. Bedrooms 4 No. Bathrooms 4 No. Employees

Water Supply: ☐ Individual ☑ Public ☑ Community

☑ Slab ☑ Crawl Space ☑ Basement w/plumbing ☐ Basement wo/plumbing

Comments:/Conditions:


Comments:/Conditions: (PARTIAL)
Checked lines 5/16/06 MD
Cracked tanks 9/7/06

1"=50'

INITIAL SITE SKETCH



AS BUILT SKETCH

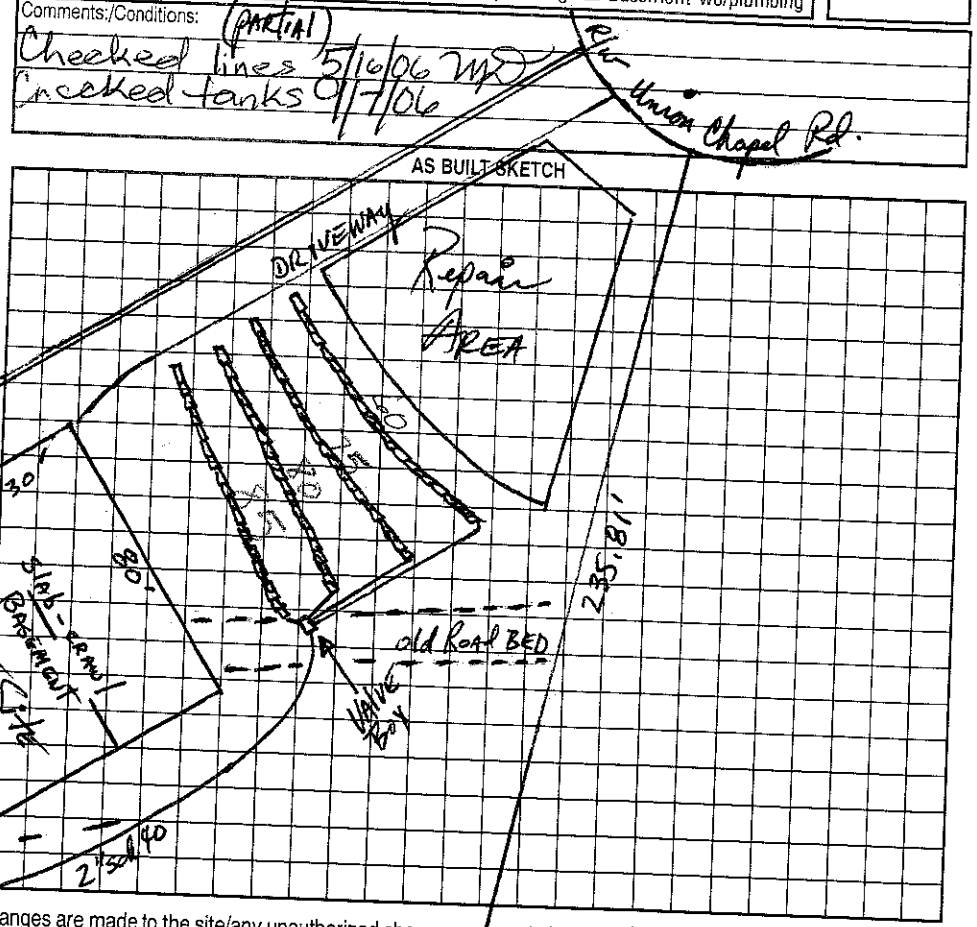

Permit can be suspended or revoked if any false information is supplied toward securing the permit/any unauthorized changes are made to the site/any unauthorized changes are made in the installation of the system. Improvement Permit with plat valid without expiration. Improvement Permit with site plan valid for sixty months. Authorization to Construct is valid for a period equal to that of Improvement Permit – not to exceed sixty months.

Signed: Kate Ross date 9-23-99 Installed by: R&H

Improvement Permit by: [signature] date 9-23-99 Operation Permit by: Wesley Speed RS. date 9/25/06

Authorization to Construct by: [signature] RS date 6/23/05 Existing System Inspection by: date

760 Lake Norman

HEALTH DEPT. COPY: WHITE OWNER COPY (FINAL): YELLOW OWNER COPY (INITIAL): PINK