IREDELL COUNTY HEALTH DEPARTMENT

STATESVILLE 704-878-5305 50.00 Paid MOORESVILLE 704-664-5281

IMPROVEMENT PERMIT / AUTHORIZATION TO CONSTRUCT / OPERATION PERMIT / EXISTING SYSTEM INSPECTION

PERMIT# 081280 PIN# ~~4625-84-1684~~ 4625-65-3489 DATE 9/4/01

OWNER OR CONTRACTOR Simonini Builders PHONE: Business 201-8976 Home

ADDRESS 817 E. Moorland ST. Charlotte NC 28202

LOCATION Crawley sch, TR Polpis, TL Jeremy Pt, TR Brick Kiln, TL Unionchapel, at end on Rt

SUBDIVISION The Point BLOCK / SECTION 5 LOT 536 LOT AREA 39,633 ft² SITE CLASS. PS DESIGN FLOW 600 L.T.A.R. 0.3

Septic Tank: 1500 Gallons; STB 338 Date 12/14/02
Pump Tank: 1500 Gallons; PT 338 Date 10/6/02
Pump Make: Gould's Model WE10J2HP Serial No.
Nitrification Field: No Fields 1 Square Feet 1008 Linear Feet 336
No Lines 4@84' Trench Width 36" Max Trench Bottom Depth 36" Gravel Depth —

☒ New System ☐ Repair System Type: I, II, III, IV, V, VI
System Description: LP Panel Block
Repair System Description: Same
Maintenance Agreement Required: ☐ Yes ☒ No

☒ House/Mod. Home No. Bedrooms 5
☐ Mobile Home No. Bathrooms 5
☐ Business No. Employees
☐ Other

☐ Slab ☐ Crawl Space ☒ Basement w/plumbing ☐ Basement wo/plumbing


Water Supply: ☐ Individual ☐ Public ☒ Community

Comments:/Conditions:


Comments:/Conditions:
Drive will be on opposite side

1" = 50'

INITIAL SITE SKETCH

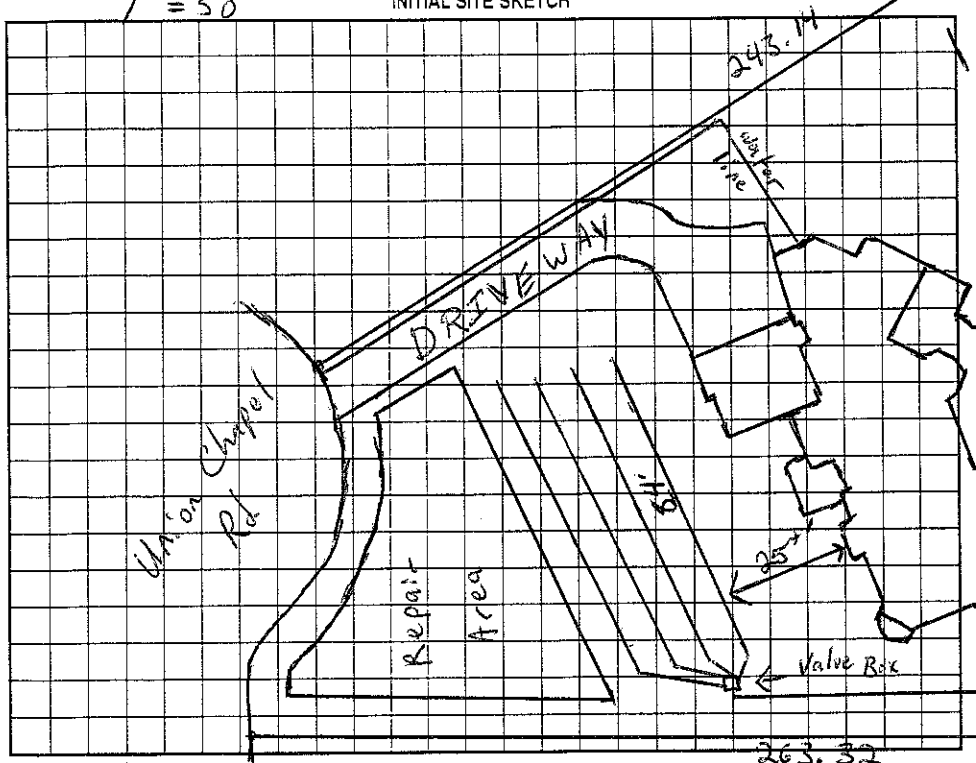

AS BUILT SKETCH

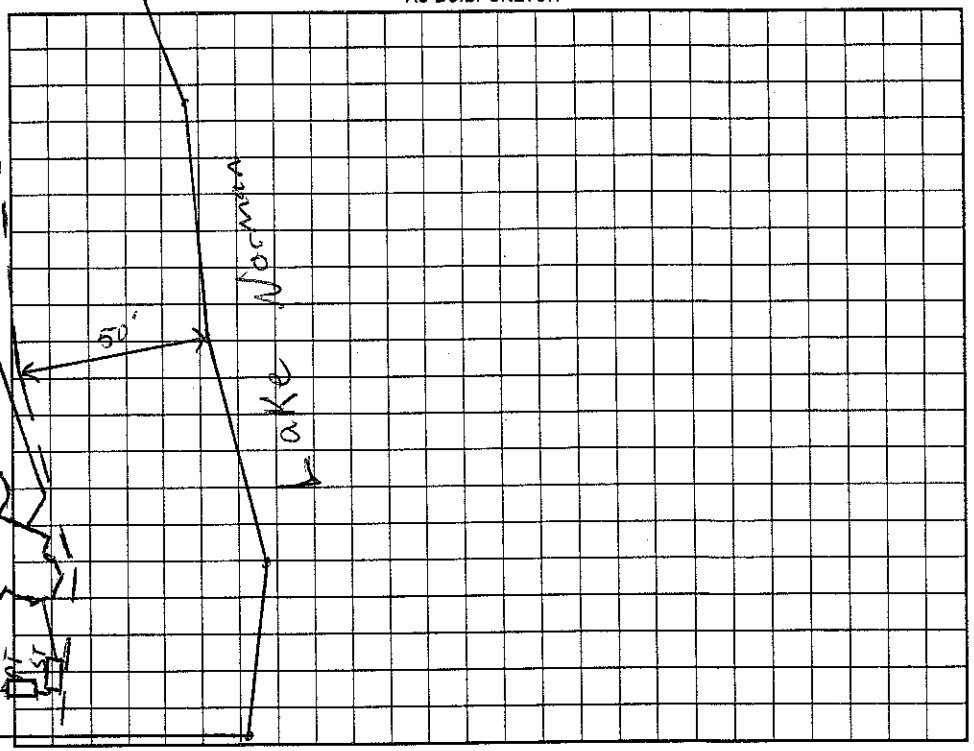

Permit can be suspended or revoked if any false information is supplied toward securing the permit/any unauthorized changes are made to the site/any unauthorized changes are made in the installation of the system. Improvement Permit with plat valid without expiration. Improvement Permit with site plan valid for sixty months. Authorization to Construct is valid for a period equal to that of Improvement Permit – not to exceed sixty months.

Signed: Dawn D. Crist date 9/7/01

Improvement Permit by: RS date 9/4/01

Authorization to Construct by: RS date 9/4/01

Installed by: Hillman Const

Operation Permit by: RS date 6/24/03

Existing System Inspection by: date

HEALTH DEPT. COPY: WHITE OWNER COPY (FINAL): YELLOW OWNER COPY (INITIAL): PINK