IREDELL COUNTY HEALTH DEPARTMENT

STATESVILLE 704-878-5305 (O) MOORESVILLE 704-664-5281

IMPROVEMENT PERMIT / AUTHORIZATION TO CONSTRUCT / OPERATION PERMIT / EXISTING SYSTEM INSPECTION

PERMIT# 1326620 PIN# 4625 65 5530 . 000 DATE 11/28/05

OWNER OR CONTRACTOR Pam + James Mack PHONE: Business 704 902 5827 Home

ADDRESS 150 Union Chapel Rd, Mooresville, 28117

LOCATION 1100 (R) Polpis (L) Jeremy Point (R) Brick Kiln (L) Union Chapel on (R) near culdesac

SUBDIVISION Point BLOCK / SECTION 5 LOT 535 LOT AREA .747 SITE CLASS. PS DESIGN FLOW 480 L.T.A.R. .3

Septic Tank: Existing Gallons: STB Date

Pump Tank: Gallons: PT Date

Pump Make: Model Serial No.

Nitrification Field: No Fields Square Feet Linear Feet

No Lines 3 Trench Width Max Trench Bottom Depth Gravel Depth

☐ New System ☐ Repair System Type: I, II, III, IV, V, VI

System Description: Pro-Dosed - 16" PPBPS

Repair System Description:

Maintenance Agreement Required: ☒ Yes ☐ No

☒ House/Mod. Home No. Bedrooms 4

☐ Mobile Home No. Bathrooms 4

☐ Business No. Employees

☐ Other


☐ Slab ☐ Crawl Space ☒ Basement w/plumbing ☐ Basement wo/plumbing

Water Supply:
☐ Individual
☐ Public
☒ Community
Point


Comments:/Conditions:

Comments:/Conditions:

AS BUILT ~~INITIAL SITE SKETCH~~ SKETCH

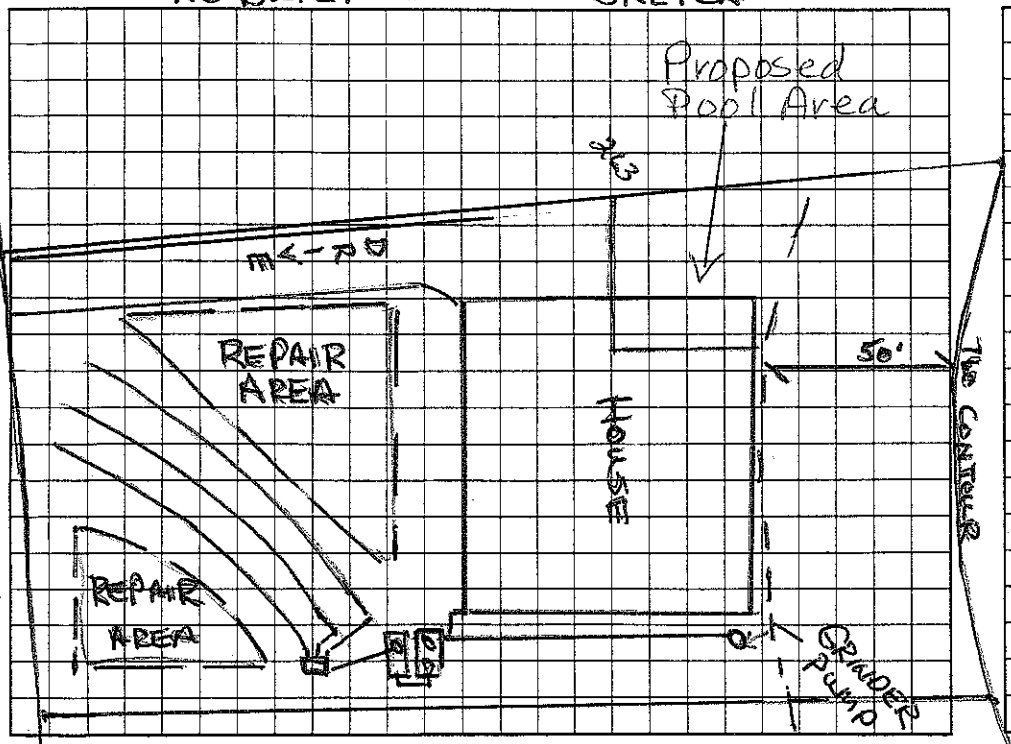

AS BUILT SKETCH

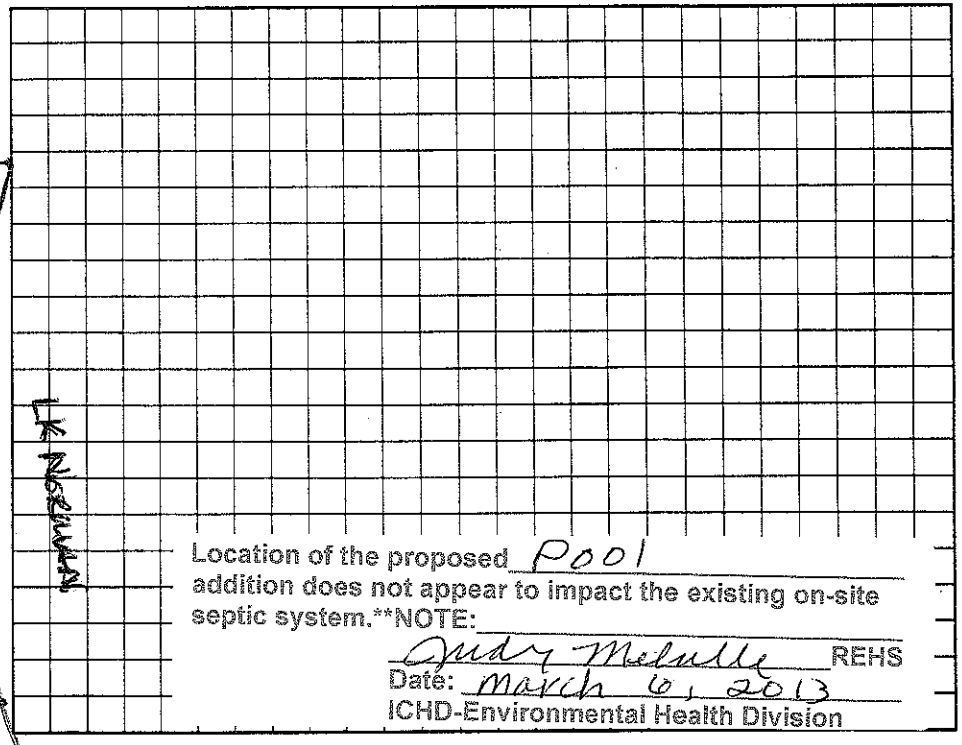

Location of the proposed Pool addition does not appear to impact the existing on-site septic system.**NOTE:

Judy Melville REHS

Date: March 6, 2013

ICHD-Environmental Health Division

Permit can be suspended or revoked if any false information is supplied toward securing the permit/any unauthorized changes are made to the site/any unauthorized changes are made in the installation of the system. Improvement Permit with plat valid without expiration. Improvement Permit with site plan valid for sixty months. Authorization to Construct is valid for a period equal to that of Improvement Permit – not to exceed sixty months.

Signed: * Pam Mack date 03-17-06

Improvement Permit by: MD date

Authorization to Construct by: MD. date

Installed by: R+N

Operation Permit by: GMcN date

Existing System Inspection by: Wesley Sperkas RS date 11/28/05

HEALTH DEPT. COPY: WHITE OWNER COPY (FINAL): YELLOW OWNER COPY (INITIAL): PINK