IREDELL COUNTY HEALTH DEPARTMENT

STATESVILLE 704-878-5305 MOORESVIL 704-5...

IMPROVEMENT PERMIT / AUTHORIZATION TO CONSTRUCT / OPERATION PERMIT / EXISTING SYSTEM INSPECTION

PERMIT# 081371 PIN# 4625944684 (pt) 4625-65-6230 DATE Sept 18, 03

OWNER OR CONTRACTOR CRI // Young Bld. Inc. PHONE: Business Home

ADDRESS 15669 Birkdale Commons Pkwy Huntersville, N.C. 28078

LOCATION Brawley Sch Rd. TR Polaris TL Jeremy Pt. TR Brick Kiln TL Union Chapel on left

SUBDIVISION The Point BLOCK / SECTION 5 LOT 541 LOT AREA 35,662 sf SITE CLASS. DESIGN FLOW 480gpd L.T.A.R. .25

Septic Tank: 1500 Gallons; STB 338 Date 5/25/04
Pump Tank: 1000 Gallons; PT 283 Date 5/22/04
Pump Make: Goulds Model WE5-512HHU Serial No. 6/30/04
Nitrification Field: No Fields 1 Square Feet 640/960 Linear Feet 320
No Lines 3 @ 107' Trench Width 24" min 8' oc Max Trench Bottom Depth 36" Gravel Depth NA

☑ New System ☐ Repair System Type: I, II, III, IV, V, VI
System Description: LPPPBPS
Repair System Description: LPPPBPS
Maintenance Agreement Required: ☑ Yes ☐ No

☑ House/Mod. Home No. Bedrooms 4
☐ Mobile Home No. Bathrooms 4.5
☐ Business No. Employees
☐ Other

☐ Slab ☐ Crawl Space ☑ Basement w/plumbing ☐ Basement wo/plumbing


Water Supply: ☐ Individual ☑ Public ☑ Community

Comments/Conditions: OR 36" MAX 9' OC


Comments/Conditions:

1" = 40'

INITIAL SITE SKETCH

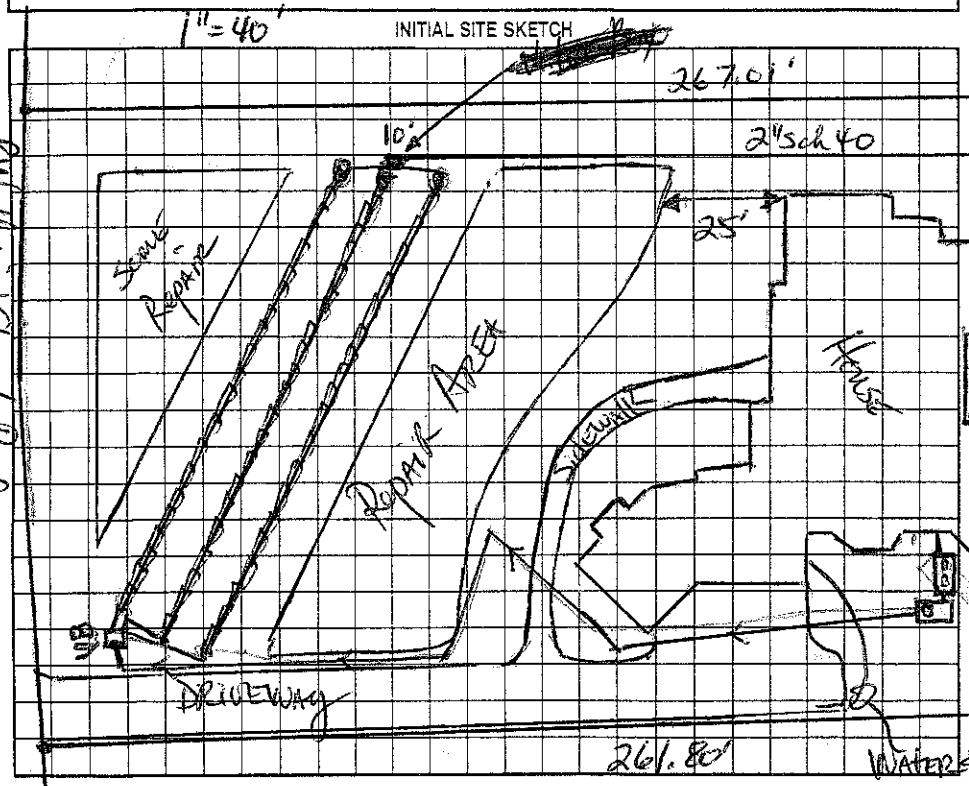

AS BUILT SKETCH

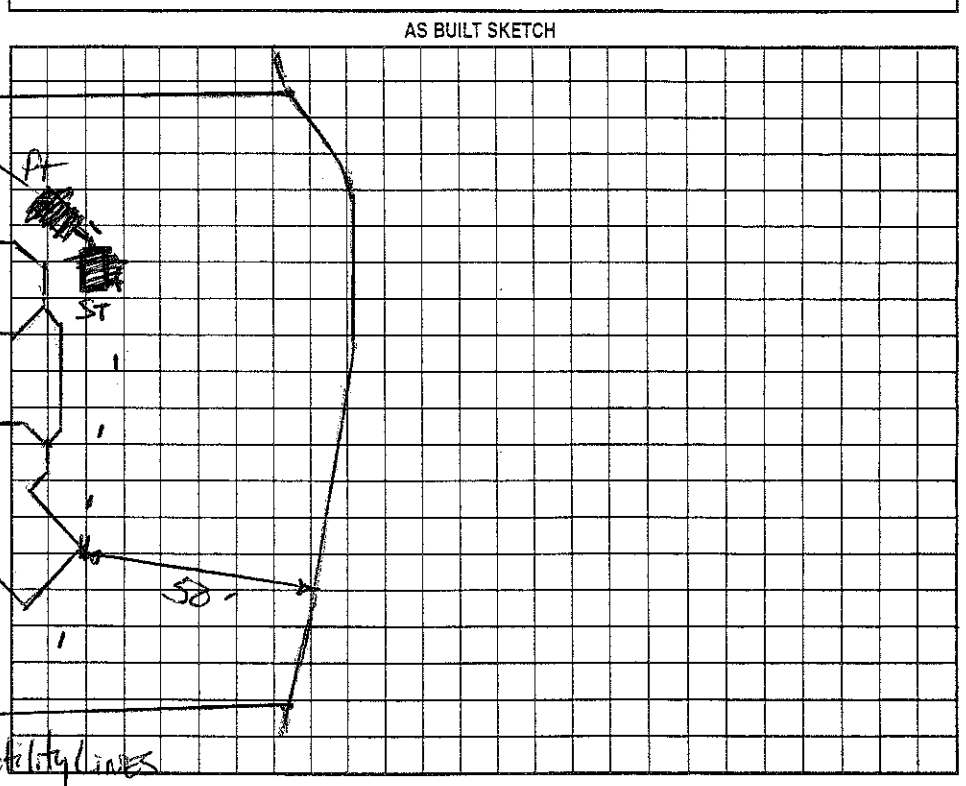

Permit can be suspended or revoked if any false information is supplied toward securing the permit/any unauthorized changes are made to the site/any unauthorized changes are made in the installation of the system. Improvement Permit with plat valid without expiration. Improvement Permit with site plan valid for sixty months. Authorization to Construct is valid for a period equal to that of Improvement Permit – not to exceed sixty months.

Signed: date 9-22-03 Installed by: Osbon + Sons Const.

Improvement Permit by: date 9-18-03 Operation Permit by: Wesley Sparks RS. date 7/6/04

Authorization to Construct by: date 9-18-03 Existing System Inspection by: date

HEALTH DEPT. COPY: WHITE OWNER COPY (FINAL): YELLOW OWNER COPY (INITIAL): PINK