IREDELL COUNTY HEALTH DEPARTMENT

STATESVILLE 704-878-5305 MOORESVILLE 704-664-5281

IMPROVEMENT PERMIT / AUTHORIZATION TO CONSTRUCT / OPERATION PERMIT / EXISTING SYSTEM INSPECTION

$125 333 + 333 11:00

PERMIT# 081278 PIN# ~~4625946864~~ (lot) / 4625656563 DATE Sept. 2, '99

OWNER OR CONTRACTOR Crescent Resources dev / The Point or Norman / CORNERSTONE Builders PHONE: Business 660-1165 Home

ADDRESS 2214 Brawley Sch Rd. Mooresville

LOCATION Brawley Sch Rd. TR Polper Rd. TL Jeremy Pt. TR Brick Kiln TL Union Chapel on Right

SUBDIVISION The Point BLOCK SECTION 5 LOT 534 LOT AREA 36,479 ft² SITE CLASS. PS DESIGN FLOW 460 gpd L.T.A.R. .3

Septic Tank: 1000+ Gallons; STB 338 Date 4-7-01
Pump Tank: 1000 Gallons; PT 283 Date 3-27-01
Pump Make: Model Serial No.
Nitrification Field: No Fields 1 Square Feet 1200 Linear Feet 400
No Lines 4@100 Trench Width 36" Max Trench Bottom Depth 36" Gravel Depth NA

☑ New System ☐ Repair System Type: I, II, III, IV, V, VI
System Description: * PM-INNOVATIVE-25% Reduction
Repair System Description: LP Panel Block
Maintenance Agreement Required: ☐ Yes ☑ No initially


☐ House/Mod. Home No. Bedrooms 4
☐ Mobile Home No. Bathrooms 4
☐ Business No. Employees
☐ Other
☑ Slab ☑ Crawl Space ☑ Basement w/plumbing ☐ Basement wo/plumbing


Water Supply: ☐ Individual ☑ Public ☐ Community

Comments/Conditions: * ADS 2012 may be best drainfield option due to ~~to~~ contour.
6-20-2000 Reviewed change of site plan; Substantially in compliance w/ I.P.; No closet in studio & Do not cut AREA Above silt fence. System type should still go as Shown. DRH

Comments/Conditions: (PARTIAL) Check drain lines 3/8/2001 mp
AS BUILT SKETCH: Installed EZ Flow

INITIAL SITE SKETCH 1"=50'

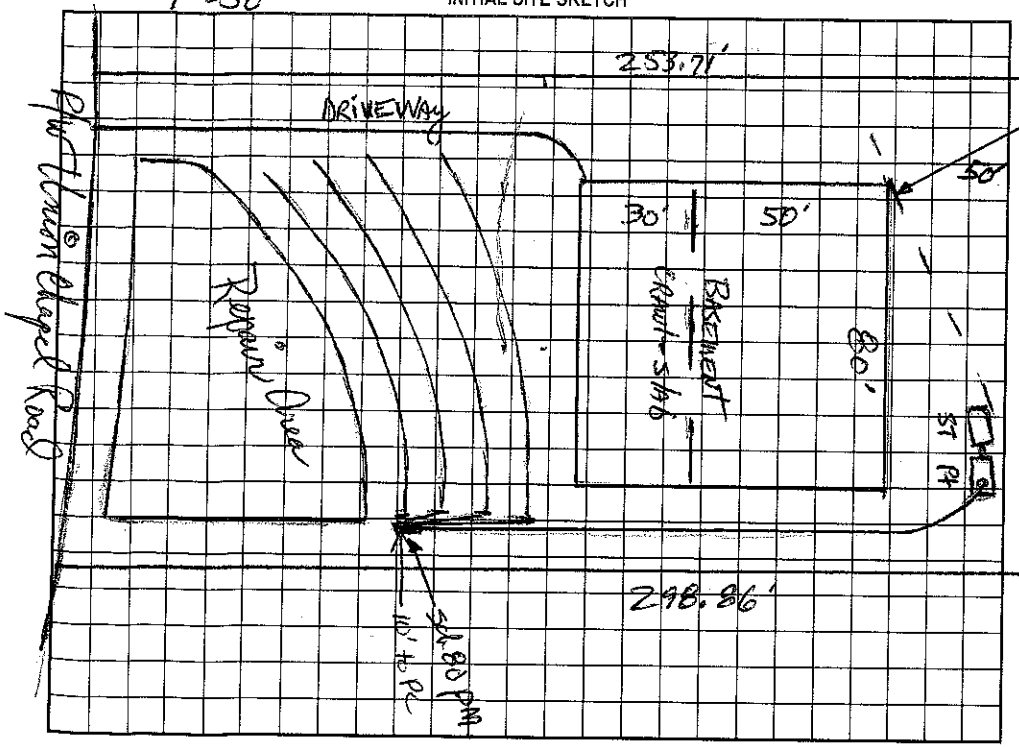

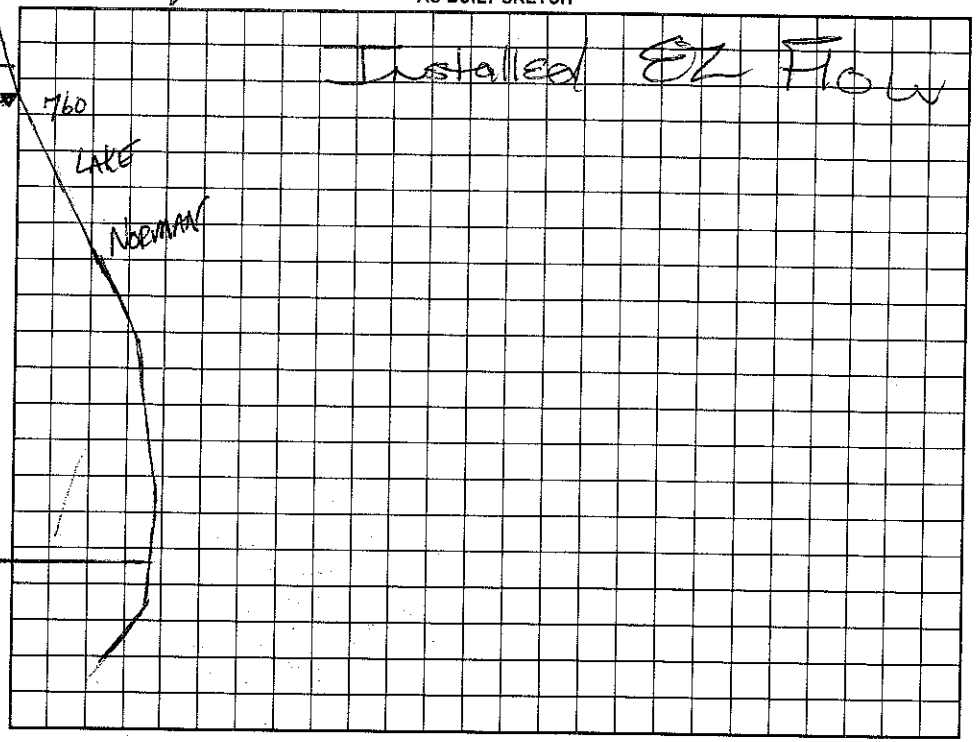

Permit can be suspended or revoked if any false information is supplied toward securing the permit/any unauthorized changes are made to the site/any unauthorized changes are made in the installation of the system. Improvement Permit with plat valid without expiration. Improvement Permit with site plan valid for sixty months. Authorization to Construct is valid for a period equal to that of Improvement Permit – not to exceed sixty months.

Signed: P.K. R.

Improvement Permit by: Thomas D. Johnson, RS date 9-2-99

Authorization to Construct by: David H. Johnson, RS date 6-20-00

Installed by: R & H

Operation Permit by: Mark H. Dobson, RS date 7/19/2001

Existing System Inspection by: date

HEALTH DEPT. COPY: WHITE OWNER COPY (FINAL): YELLOW OWNER COPY (INITIAL): PINK