Posted 9/19/01 MD

IREDELL COUNTY HEALTH DEPARTMENT

$325

STATESVILLE 704-878-5305 MOORESVILLE 704-664-5281

IMPROVEMENT PERMIT / AUTHORIZATION TO CONSTRUCT / OPERATION PERMIT / EXISTING SYSTEM INSPECTION

PERMIT# 081373 PIN# ~~4675944684~~ (Lot) Hughes Homesite 4 Family Bld. 4625-65-8282 DATE Sept 3, 199

OWNER OR CONTRACTOR Crescent Resources Dev. // The Point on Norman // PHONE: Business 660-1185 Home

ADDRESS 2214 Brawley Sch Rd. Mooresville

LOCATION Brawley Sch Rd. TR Polpis TL Jeremy PT. TR Brick Kiln TL Union Chapel on left

SUBDIVISION The Point BLOCK / SECTION 5 / LOT 543 LOT AREA 30,532 sf SITE CLASS. RS DESIGN FLOW 480gpd L.T.A.R. 1.3±

Septic Tank: 1500T Gallons; STB 338 Date 4/3/01

Pump Tank: 1000 Gallons; PT 27 Date 4/9/01

Pump Make: MYERS Model 1/2HP - High Head No.

Nitrification Field: No Fields 1 Square Feet 960 Linear Feet 320

No Lines 4@80' Trench Width 36" Max Trench Bottom Depth 36"

☑ New System ☐ Repair System Type: I, II, III, IV, V, VI

System Description: LS Panel Block

Repair System Description: None

Maintenance Agreement Required: ☑ Yes ☐ No

Gravel Depth NA

☑ House/Mod. Home No. Bedrooms 4

☐ Mobile Home No. Bathrooms 4

☐ Business No. Employees

☐ Other

☑ Slab ☐ Crawl Space ☑ Basement w/plumbing ☐ Basement wo/plumbing

Water Supply: ☐ Individual ☑ Public ☐ Community

Comments:/Conditions:


1-23-01 Reviewed house & site plan; appears in compliance w/ I.P.

Comments:/Conditions: (PARTIAL)

Drainfield, Tanks, Supply lines inspected 7/18/01

1"=50'

INITIAL SITE SKETCH

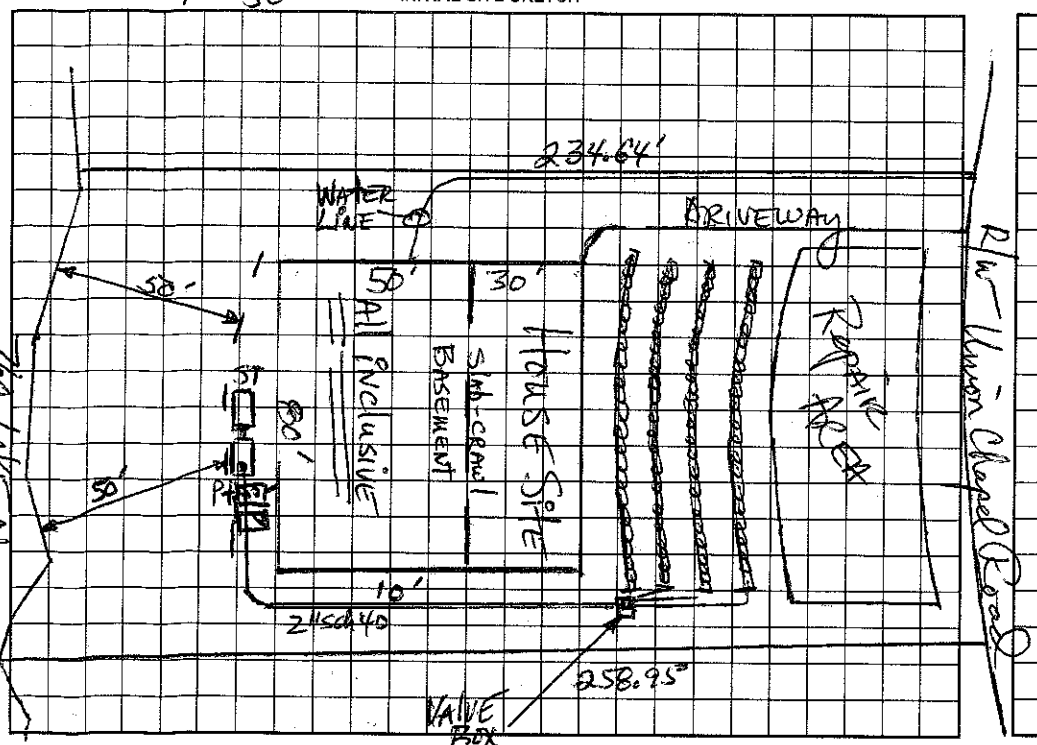

AS BUILT SKETCH

Permit can be suspended or revoked if any false information is supplied toward securing the permit/any unauthorized changes are made to the site/any unauthorized changes are made in the installation of the system. Improvement Permit with plat valid without expiration. Improvement Permit with site plan valid for sixty months. Authorization to Construct is valid for a period equal to that of Improvement Permit – not to exceed sixty months.

Signed: [signature] date 9-10-99 Installed by: Bob Mayhew

Improvement Permit by: [signature], RS date 9-3-99 Operation Permit by: Wesley Sparks RS. date 9/18/01

Authorization to Construct by: [signature], RS date 1-23-01 Existing System Inspection by: date

HEALTH DEPT. COPY: WHITE OWNER COPY (FINAL): YELLOW OWNER COPY (INITIAL): PINK