IREDELL COUNTY HEALTH DEPARTMENT

STATESVILLE 704-878-5305 $125 MOORESVILLE 704-664-5281

Start?

IMPROVEMENT PERMIT / AUTHORIZATION TO CONSTRUCT / OPERATION PERMIT / EXISTING SYSTEM INSPECTION

PERMIT# 08/275 PIN# 4625941683 (pt.) Brookshire Const. 4625659561 DATE August 25, '99

OWNER OR CONTRACTOR Crescent Resources Inc. // The Point on Norman PHONE: Business 660-7185 Home

ADDRESS 2214 Brawley Sch Rd. Mooresville

LOCATION Brawley Sch Rd. TR Polpies Rd. TL Jeremy Pt. TR Brick Kiln TL Union Chapel on Right

SUBDIVISION The Point BLOCK / SECTION 5 LOT 532 LOT AREA 89,077 ft² SITE CLASS. PS DESIGN FLOW 480gpd L.T.A.R. .3

Septic Tank: 1000+500 Gallons; STB 338 Date 3-18-01

Pump Tank: 1000 Gallons; PT 283 Date

Pump Make: Model Serial No.

Nitrification Field: No Fields 1 Square Feet 1200 Linear Feet 400

No Lines 3 Trench Width 36" Trench Bottom Depth 36" Gravel Depth NA

☑ New System ☐ Repair System Type: I, II, (III) IV, V, VI

System Description: PM-INNOVATIVE - 25% Reduction

Repair System Description: SAME

Maintenance Agreement Required: ☐ Yes ☑ No

☑ House/Mod. Home ☐ Mobile Home ☐ Business ☐ Other

No. Bedrooms 4 No. Bathrooms 4 No. Employees


☑ Slab ☑ Crawl Space ☑ Basement w/plumbing ☐ Basement wo/plumbing

Water Supply: ☐ Individual ☑ Public ☑ Community


Comments/Conditions: *ONE inspection port per Lateral. 9-20-00 Reviewed house & site plan; Appears substantially in compliance w/ IP

Comments:/Conditions: (partial) 5/8/2001 Checked lines & tanks 5/8/2001 MS Date not on PT, let sit till 6/5/2001 Filter & riser installed.

INITIAL SITE SKETCH 1" = 50'

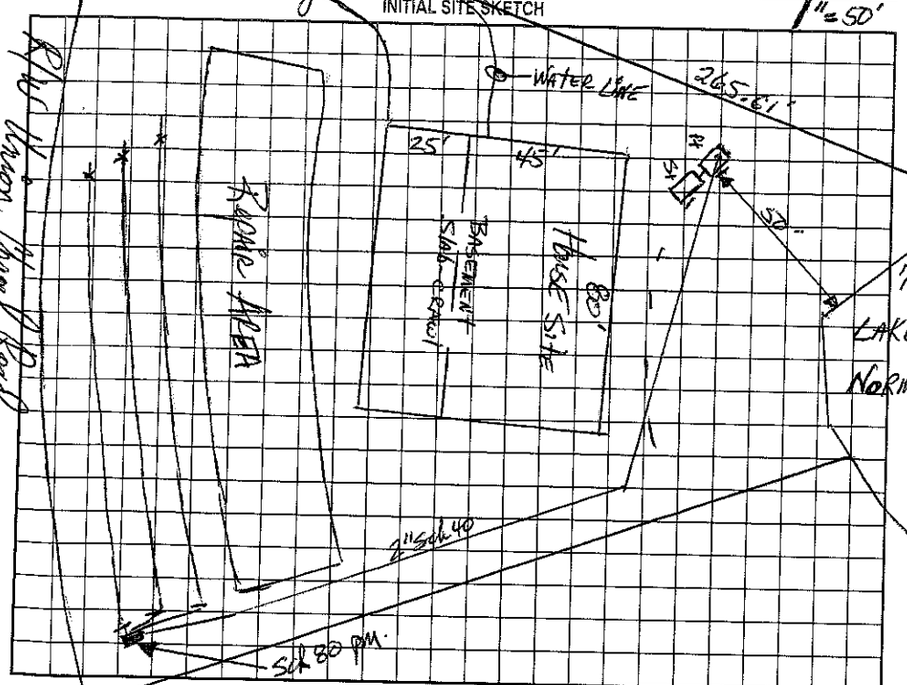

AS BUILT SKETCH

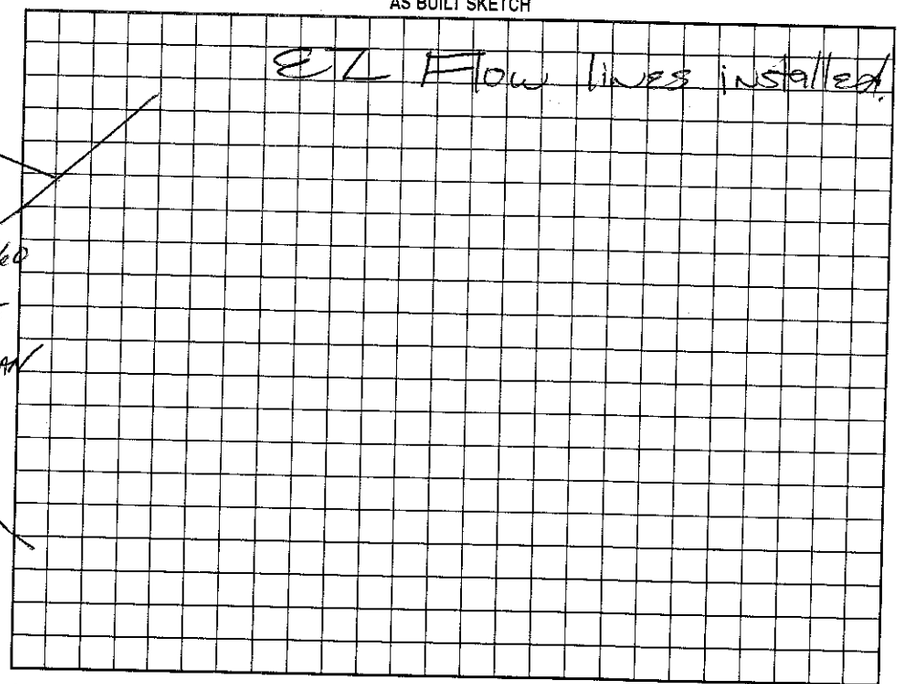

Permit can be suspended or revoked if any false information is supplied toward securing the permit/any unauthorized changes are made to the site/any unauthorized changes are made in the installation of the system. Improvement Permit with plat valid without expiration. Improvement Permit with site plan valid for sixty months. Authorization to Construct is valid for a period equal to that of Improvement Permit – not to exceed sixty months.

Signed: [signature] date 9-10-99

Improvement Permit by: [signature], RS date 8-25-99

Authorization to Construct by: [signature], RS date 9-20-00

Installed by: R & H INC.

Operation Permit by: [signature] RSI date 8/22/01

Existing System Inspection by: date

HEALTH DEPT. COPY: WHITE OWNER COPY (FINAL): YELLOW OWNER COPY (INITIAL): PINK