# IREDELL COUNTY HEALTH DEPARTMENT

STATESVILLE 704-878-5305

## IMPROVEMENT PERMIT / AUTHORIZATION TO CONSTRUCT / OPERATION PERMIT / EXISTING SYSTEM INS.

PERMIT# 81259 PIN# ~~4625944684~~ PT 4625668031 DATE 5/23,01

OWNER OR CONTRACTOR CRESCENT RESOURCES / HUGHS+HA NUCK PHONE: Business 375-5999 Home

ADDRESS 909 EAST BLD · CHARLOTTE

LOCATION BRAWLEY SCHOOL - TR POLPES - TL SERENY @PT. - TR BRICK KILN-AT END

SUBDIVISION POINT BLOCK / SECTION 5 LOT 528 LOT AREA 51,351 ± SITE CLASS PS DESIGN FLOW 480GPD L.T.A.R. 360PD/FT2

Septic Tank: ~~1500~~ Gallons; STB 338 Date 6/9/01

Pump Tank: Gallons; PT Date

Pump Make: Model Serial No.

Nitrification Field: No Fields 1 Square Feet 1200 Linear Feet 400

No Lines 5@80' Trench Width 36" Max Trench Bottom Depth 36" Gravel Depth N/A

☑ New System ☐ Repair System Type: I, II, (III), IV, V, VI

System Description: GRAVITY 25% REDUCTION

Repair System Description: LP PANEL

Maintenance Agreement Required: ☐ Yes ☑ No

☑ House/Mod. Home No. Bedrooms 4

☐ Mobile Home No. Bathrooms 4

☐ Business No. Employees

☐ Other


☐ Slab ☑ Crawl Space ☐ Basement w/plumbing ☐ Basement wo/plumbing

Water Supply: ☐ Individual ☐ Public ☑ ~~Community~~


Comments:/Conditions (REVISED)

Comments:/Conditions: EZ Flow installed

INITIAL SITE SKETCH

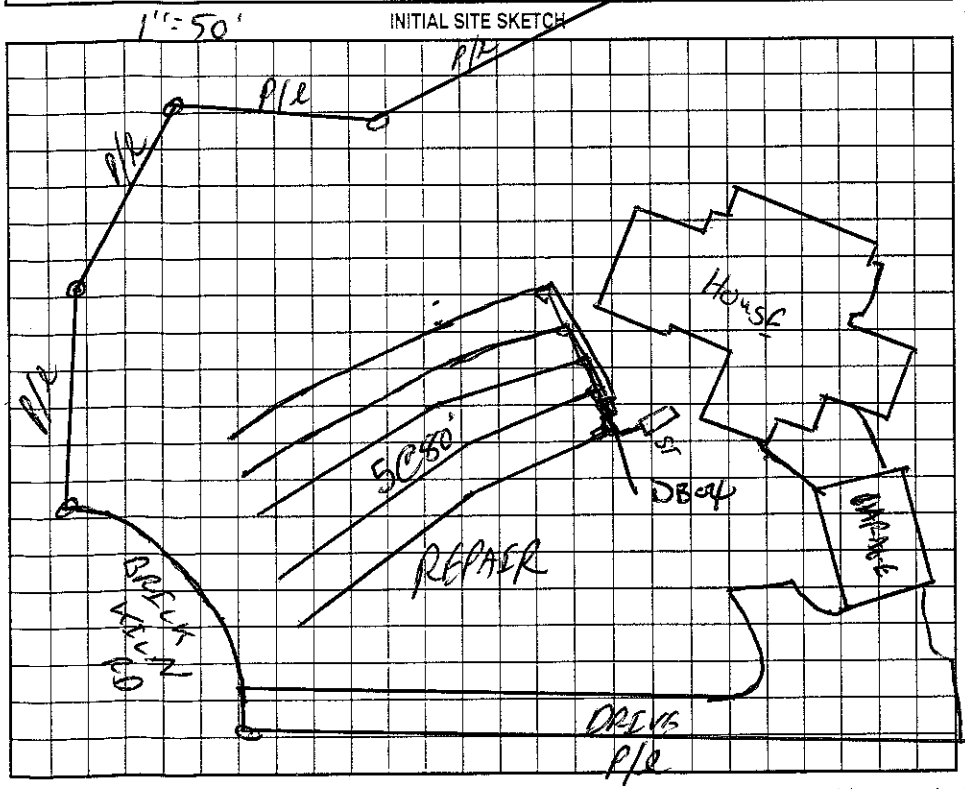


AS BUILT SKETCH

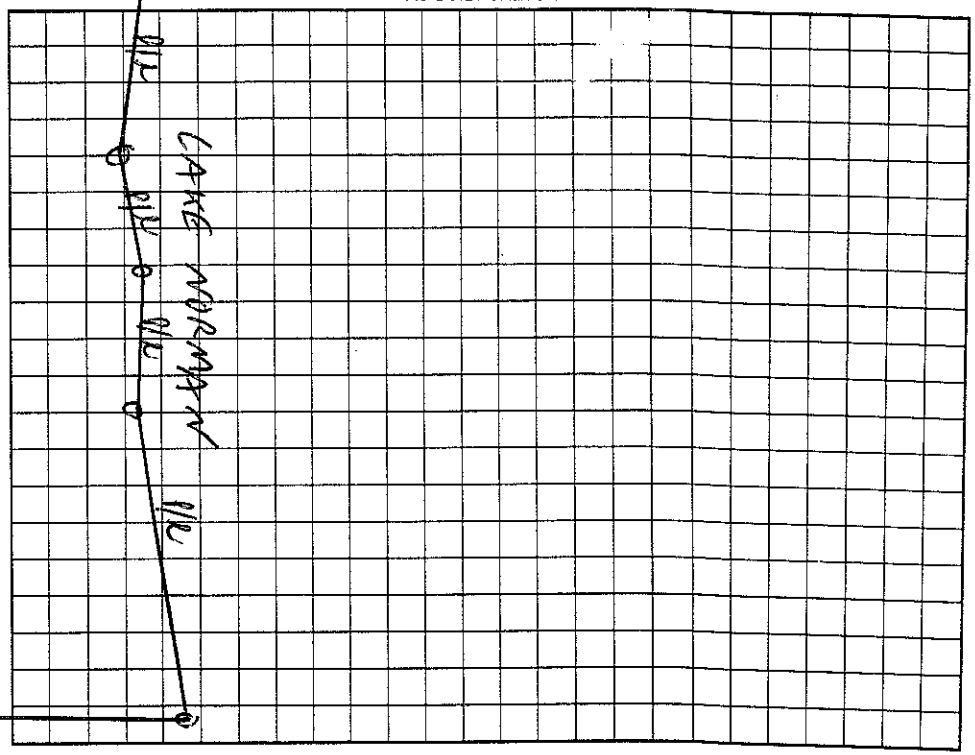


Permit can be suspended or revoked if any false information is supplied toward securing the permit/any unauthorized changes are made to the site/any unauthorized changes are made in the installation of the system. Improvement Permit with plat valid without expiration. Improvement Permit with site plan valid for sixty months. Authorization to Construct is valid for a period equal to that of Improvement Permit – not to exceed sixty months.

Signed: T.S. date 5-25-01 Installed by: Bob Mayhew

Improvement Permit by: C. RS date 5/25/01 Operation Permit by: Winkler Sanitors date 8/16/01

Authorization to Construct by: C. RS date 5/25/01 Existing System Inspection by: date

HEALTH DEPT. COPY: WHITE OWNER COPY (FINAL): YELLOW OWNER COPY (INITIAL): PINK