IREDELL COUNTY HEALTH DEPARTMENT

STATESVILLE 704-878-5305 MOORESVILLE 704-664-5281

IMPROVEMENT PERMIT / AUTHORIZATION TO CONSTRUCT / OPERATION PERMIT / EXISTING SYSTEM INSPECTION

PERMIT# 82345 PIN# 4625 94 1684 4625-67-8985 DATE 4/12/05

OWNER OR CONTRACTOR Eldred Custom Homes PHONE: Business 704-987-5022 Home

ADDRESS 16405-C Northcross Dr. Huntersville, NC 28078

LOCATION White House Dr. 1100 TR Mentons Mill TL White House Dr. on (R) at Cul de sac

SUBDIVISION Point BLOCK / SECTION 4 LOT 422 LOT AREA 1.02 AC SITE CLASS. PS DESIGN FLOW 600 L.T.A.R. .3 (Easement Area)

Septic Tank: 1500 Gallons; STB 338 Date 6/25/05
Pump Tank: 1500 Gallons; PT 77 Date 7/10/05
Pump Make: Goulds Model WE0 1512 HU Serial No.
Nitrification Field: No Fields 1 Square Feet 1500 Linear Feet 500
No Lines 5 @ 100' Trench Width 3' Max Trench Bottom Depth 3' Gravel Depth No

[X] New System ☐ Repair System Type: I, II, (III) IV, V, VI
System Description: PM - 25% Reduction
Repair System Description: 16" PPBPS
Maintenance Agreement Required: [X] Yes ☐ No


[X] House/Mod. Home No. Bedrooms 5
☐ Mobile Home No. Bathrooms 5
☐ Business No. Employees
☐ Other
☐ Slab ☐ Crawl Space [X] Basement w/plumbing ☐ Basement wo/plumbing

Water Supply:
☐ Individual
☐ Public
[X] Community
POINT


Comments:/Conditions: System installed in S.F.E. 422A

Comments:/Conditions:

INITIAL SITE SKETCH

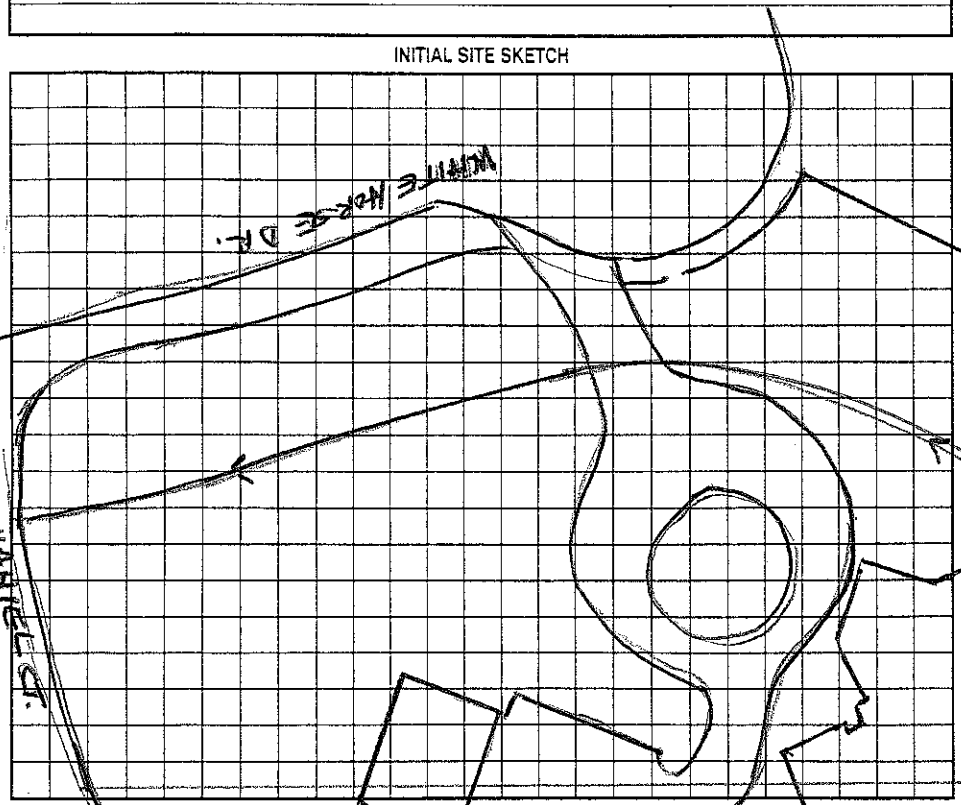

AS BUILT SKETCH

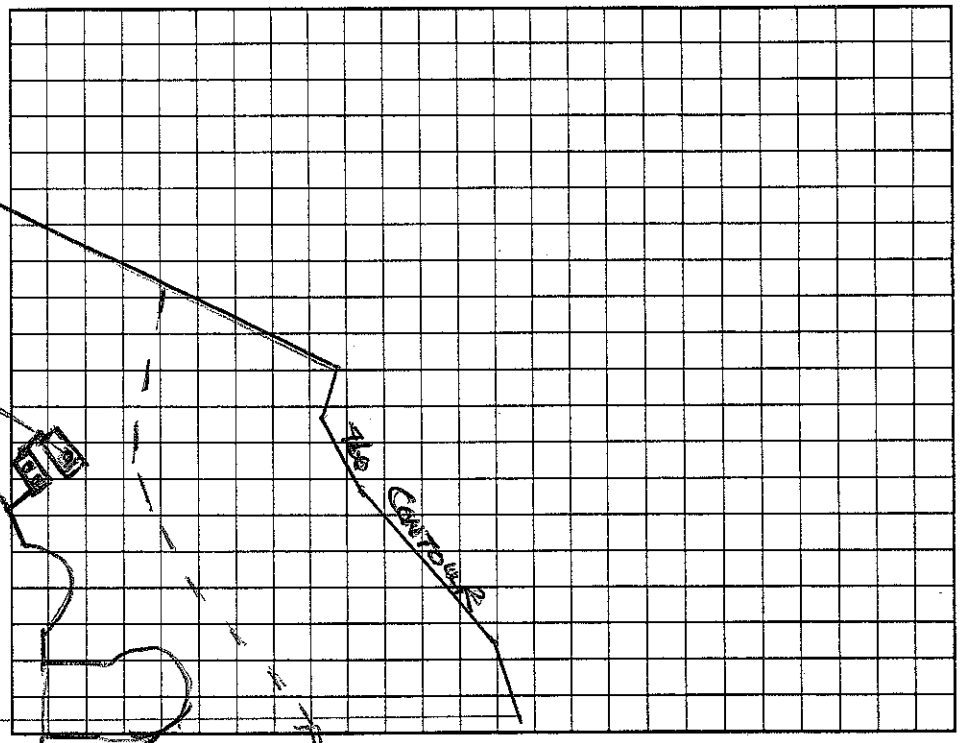

Permit can be suspended or revoked if any false information is supplied toward securing the permit/any unauthorized changes are made to the site/any unauthorized changes are made in the installation of the system. Improvement Permit with plat valid without expiration. Improvement Permit with site plan valid for sixty months. Authorization to Construct is valid for a period equal to that of Improvement Permit – not to exceed sixty months.

Signed: [signature] date 4/5/05 Installed by: Orbison Wesley Sparks RS.

Improvement Permit by: CBF date Operation Permit by: date 9/12/05

Authorization to Construct by: GMS date Existing System Inspection by: date

HEALTH DEPT. COPY: WHITE OWNER COPY (FINAL): YELLOW OWNER COPY (INITIAL): PINK