IREDELL COUNTY HEALTH DEPARTMENT

AUTH. TO CONSTRUCT

STATESVILLE 704-878-5305 MOORESVILLE 704-664-5281

IMPROVEMENT PERMIT / ~~CERTIFICATE OF COMPLETION~~ / OPERATION PERMIT / EXISTING SYSTEM INSPECTION

PROPERTY DESCRIPTION NO. 24426 DATE 8/21/96 TAX MAP NO. 2C-A-3 PT 4625 68 0717 Watershed: ☑ Yes ☐ No

OWNER OR CONTRACTOR JOHN WIELAND HOMES PHONE: Business 525-6024 Home

ADDRESS 400 STRYON ST CHARLOTTE 28201

LOCATION BRAWLEY SCHOOL RD - TR B4 HARBOR-TL LAKE MIST - 5TH LOT ON LEFT

SUBDIVISION HARBOR BLOCK / SECTION # LOT 5 LOT AREA — SITE CLASS. PS DESIGN FLOW 450 GPD L.T.A.R. .36PD/FT

Septic Tank: 1000 Gallons; STB 794 Date 8/24/97

Pump Tank: 1000 Gallons; PT 27 Date 10/5/97

Pump Make: Model Serial No.

Nitrification Field: No Fields 1 Square Feet 1587 Linear Feet 539

No Lines 7 Trench Width 36" Max Trench Bottom Depth 36" Gravel Depth 12"

☑ New System ☐ Repair System Type: I, II, III, IV, V, VI

System Description: PUMP CONVENTIONAL

Repair System Description: PUMP CONVENTIONAL

Maintenance Agreement Required: ☐ Yes ☑ No

☑ House/Mod. Home ☐ Mobile Home ☐ Business ☐ Other

No. Bedrooms 4 No. Bathrooms 3 No. Employees

☐ Slab ☑ Crawl Space ☐ Basement w/plumbing ☐ Basement wo/plumbing

Water Supply: ☐ Individual ☑ Community ☐ Public

Comments:

Comments:

530 × 6 = 3180

326 × .85 = 1480


2240

240.00


20 | 240 | 12 | 20 | 40 | 40

INITIAL SITE SKETCH

1"=50'

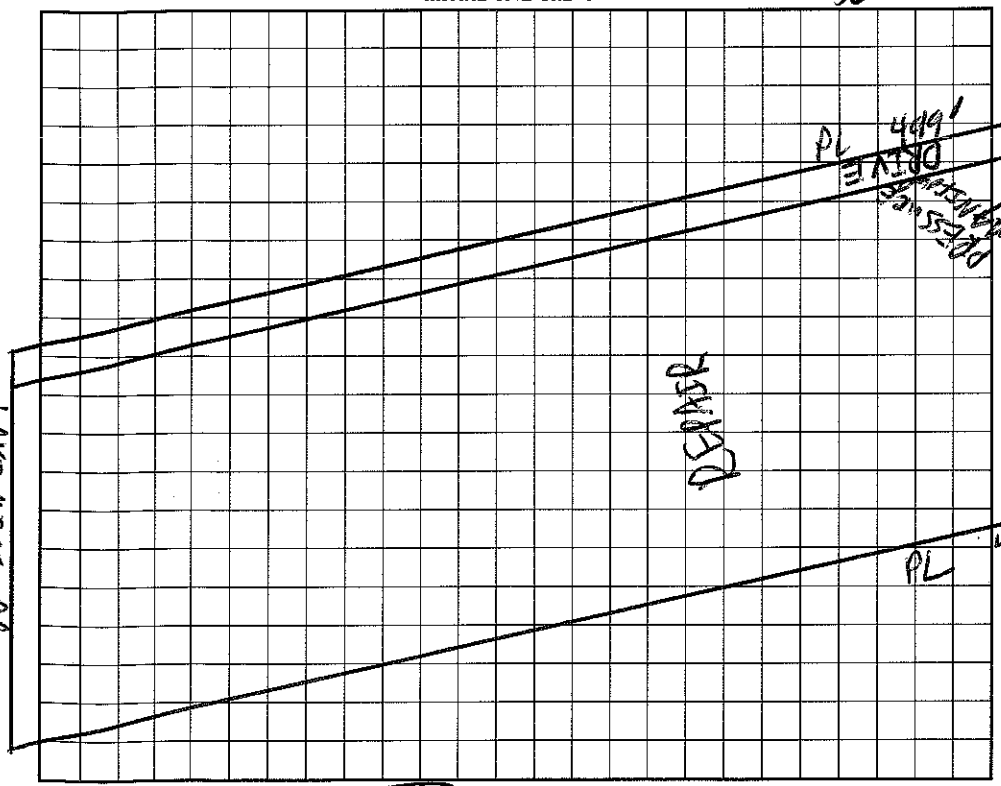

AS BUILT SKETCH

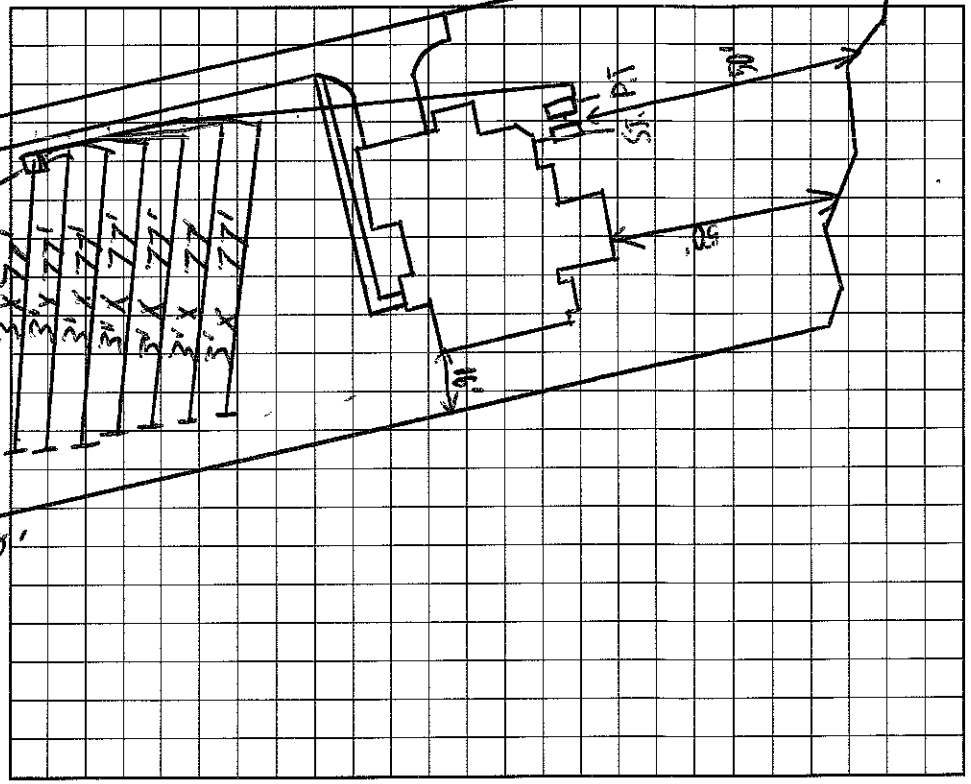

I understand ~~that this permit can be suspended or revoked~~ if any false information is supplied toward securing the permit/any unauthorized changes are made to the site/any unauthorized changes are made in the installation of the system.

Signed: Paul B. Kenny

Improvement Permit by: C. Ray Thomas EHSE date 8/21/96

AUTH. TO CONSTRUCT Existing System Inspection by: C. Ray Thomas EHSE date 8/21/96

Installed by: Morehead Const. Co.

Certificate of Completion by: Wesley Sparks RS date 2/6/98

Operation Permit by: Wesley Sparks R.S. date 2/6/98

HEALTH DEPT. COPY: WHITE INSPECTION COPY (FINAL): GREEN OWNER COPY (FINAL): YELLOW INSPECTION COPY (INITIAL): PINK OWNER COPY (INITIAL): GOLD