IREDELL COUNTY HEALTH DEPARTMENT

AUTHORIZATION TO CONSTRUCT

STATESVILLE 704-878-5305 MOORESVILLE 704-664-5281

IMPROVEMENT PERMIT / ~~CERTIFICATE OF COMPLETION~~ / OPERATION PERMIT / EXISTING SYSTEM INSPECTION

PROPERTY DESCRIPTION NO. 24425 DATE 5/22/97 TAX MAP NO. 2C-A-3 pt of Watershed: ☑ ~~Yes~~ ☐ No

OWNER OR CONTRACTOR JOHN WIELAND HOMES PHONE: Business 525-6024 Home 4625-68-0827

ADDRESS 400 S. TRYON ST CHARLOTTE NC

LOCATION BRAWLEY SCHOOL RD. TR BAY HARBOUR - TL LAKE MIST - 4TH LOT ON LEFT

SUBDIVISION HARBOUR BLOCK / SECTION II LOT 4 LOT AREA _____ SITE CLASS. PS DESIGN FLOW 480 GPD L.T.A.R. .36 GPD/FT2

Septic Tank: 1000 Gallons; STB 794 Date 4/4/97

Pump Tank: 1000 Gallons; PT 27 Date 5/22/97

Pump Make: _____ Model _____ Serial No. _____

Nitrification Field: No Fields 1 Square Feet ~~600~~ 1206 Linear Feet 402

No Lines ~~6~~ 7 Trench Width 36" Max Trench Bottom Depth 36" Gravel Depth N/A

☑ New System ☐ Repair System Type: I, II, (III), IV, V, VI

System Description: PUMP CHAMBERED OR SIMILAR

Repair System Description: SAME

Maintenance Agreement Required: ☐ Yes ☑ No

☑ House/Mod. Home ☐ Mobile Home ☐ Business ☐ Other

No. Bedrooms 4 No. Bathrooms 4 No. Employees _____


☐ Slab ☐ Crawl Space ☑ Basement w/plumbing ☐ Basement wo/plumbing

Water Supply: ☐ Individual ☑ Community ☐ Public


Comments:

Comments:

INITIAL SITE SKETCH 1"=50'

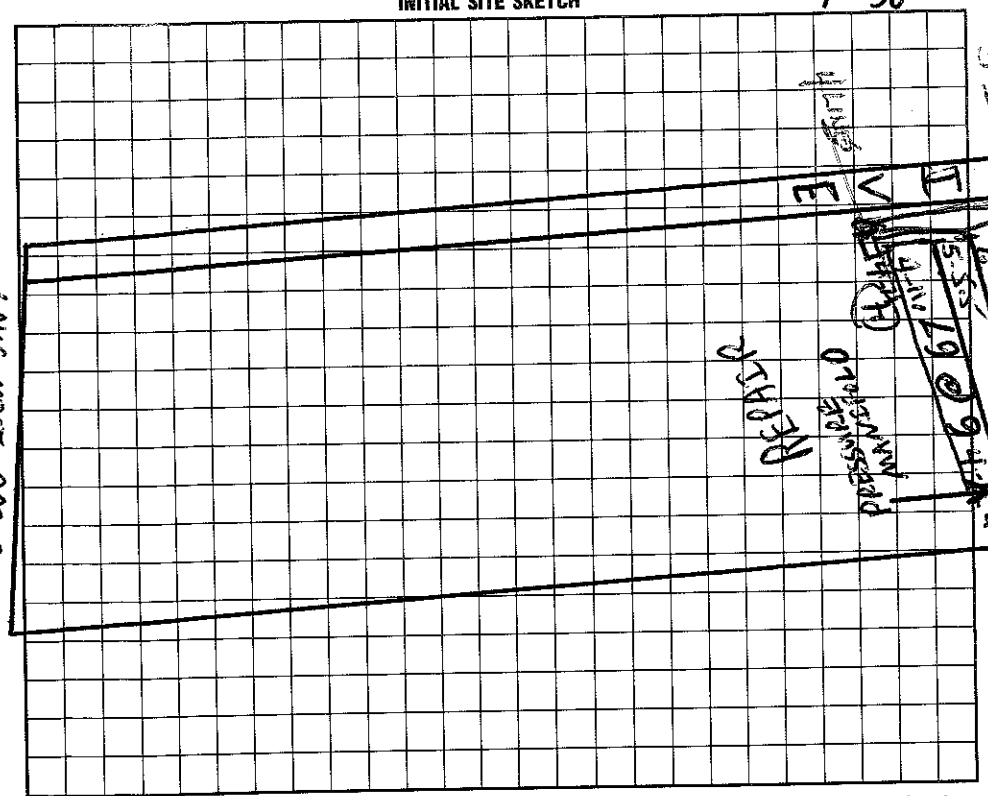

AS BUILT SKETCH

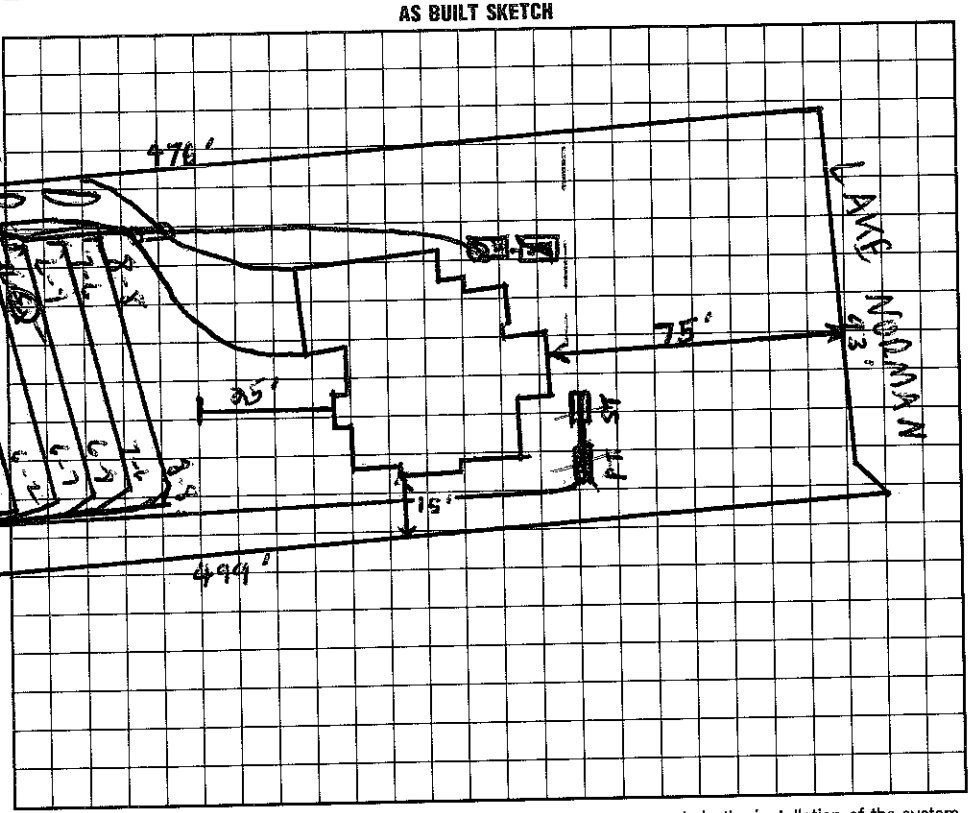

I understand that this permit can be suspended or revoked if any false information is supplied toward securing the permit/any unauthorized changes are made to the site/any unauthorized changes are made in the installation of the system. Improvement Permit is valid for 60 months from date of issuance.

Signed: _____

Improvement Permit by: C. Ray Freeman date 5/22/97

~~Existing System Inspection by:~~ AUTHORIZATION TO CONSTRUCT C. Ray Freeman date 5/22/97

Installed by: Machaod

Certificate of Completion by: Wesley Sparks R.S. date 9/10/97

Operation Permit by: Wesley Sparks R.S. date 9/10/97

HEALTH DEPT. COPY: WHITE INSPECTION COPY (FINAL): GREEN OWNER COPY (FINAL): YELLOW INSPECTION COPY (INITIAL): PINK OWNER COPY (INITIAL): GOLD