IREDELL COUNTY HEALTH DEPARTMENT

STATESVILLE 704-878-5305 MOORESVILLE 704-664-5281

IMPROVEMENT PERMIT / AUTHORIZATION TO CONSTRUCT / OPERATION PERMIT / EXISTING SYSTEM INSPECTION

PERMIT# 82103 / 12456 PIN# 4625941684 4625688269 DATE 1/12/00

OWNER OR CONTRACTOR CRESCENT RESOURCES / Dicus PHONE: Business 663 6905 Home

ADDRESS PO BOX 1003 CHARLOTTE NC 28202

LOCATION BRAWLEY SCHOOL - TR MARSTONS MILL - TL WHITE HORSE ON RT 0.4 side of E Ballston

SUBDIVISION POINT BLOCK / SECTION 4 LOT 416/417 LOT AREA 149,909 SITE CLASS. PS DESIGN FLOW 600GAD L.T.A.R. .3 GAD/FT²

Septic Tank: 1500 Gallons; STB 338 Date 8-21-05

Pump Tank: 1900 Gallons; PT 477 Date 8-26-05

Pump Make: Model Serial No.

Nitrification Field: No Fields 1 Square Feet 1500 Linear Feet 500

No Lines 5@100' Trench Width 36" Max Trench Bottom Depth 36" Gravel Depth N/A

☑ New System ☐ Repair System Type: I, II, III, IV, V, VI

System Description: PUMP 25% REDUCTION LP PANEL

Repair System Description:

Maintenance Agreement Required: ☐ Yes ☑ No OFFSITE

☑ House/Mod. Home No. Bedrooms 5

☐ Mobile Home No. Bathrooms 5

☐ Business No. Employees

☐ Other

☐ Slab ☐ Crawl Space ☑ Basement w/plumbing ☐ Basement wo/plumbing


Water Supply: ☐ Individual ☐ Public ☑ Community

Comments:/Conditions: REMOVE ALL TERRACES AND BERMS


1" = 100'

Comments:/Conditions: Cheaked tanks 9/22/05
Cheaked lines 10/19/05 MD
Installed EZ Flow drainfield.

INITIAL SITE SKETCH

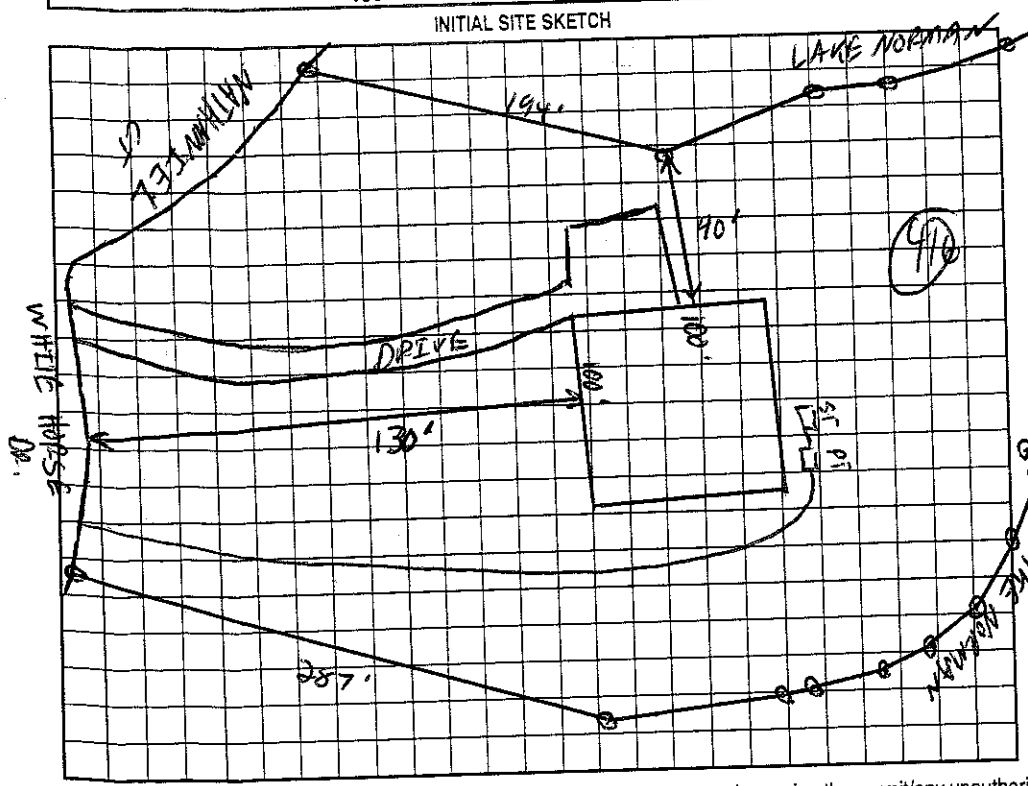

AS BUILT SKETCH 1"=50'

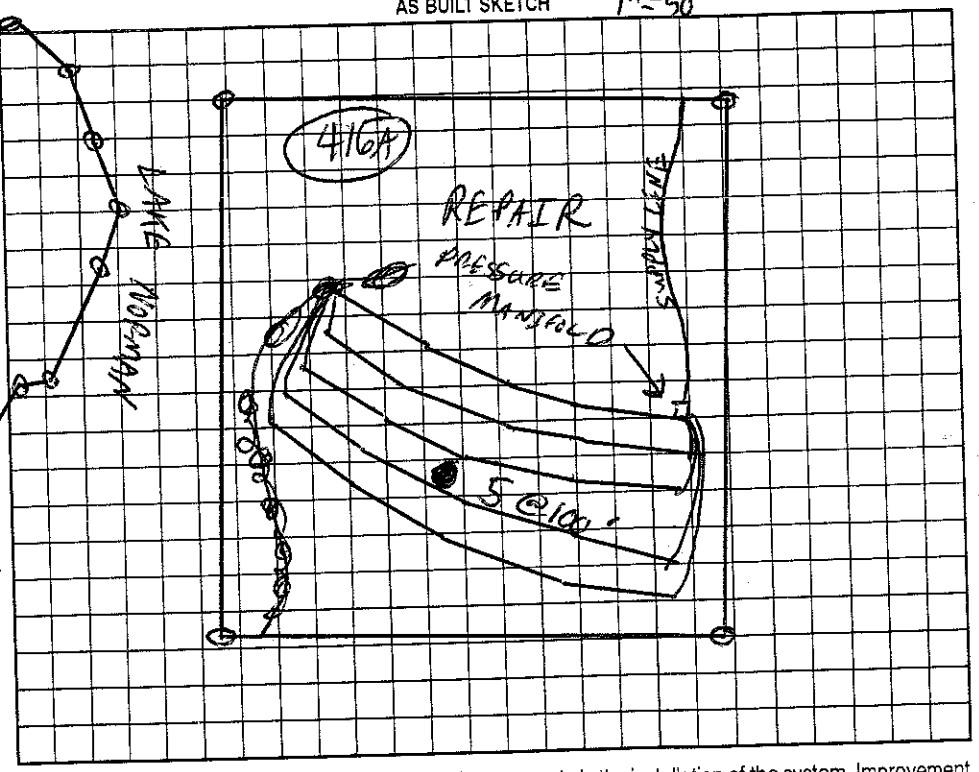

Permit can be suspended or revoked if any false information is supplied toward securing the permit/any unauthorized changes are made to the site/any unauthorized changes are made in the installation of the system. Improvement Permit with plat valid without expiration. Improvement Permit with site plan valid for sixty months. Authorization to Construct is valid for a period equal to that of Improvement Permit – not to exceed sixty months.

Signed: Paul F. date 12-1-00

PS date 1/12/00

RS date 3/30/04

Installed by: R&H Dotson RS

Operation Permit by: Marvin H. Dotson date 1/1-

Existing System Inspection by:

HEALTH DEPT. COPY: WHITE OWNER COPY (FINAL): YELLOW OWNER COPY (INITIAL): PINK